
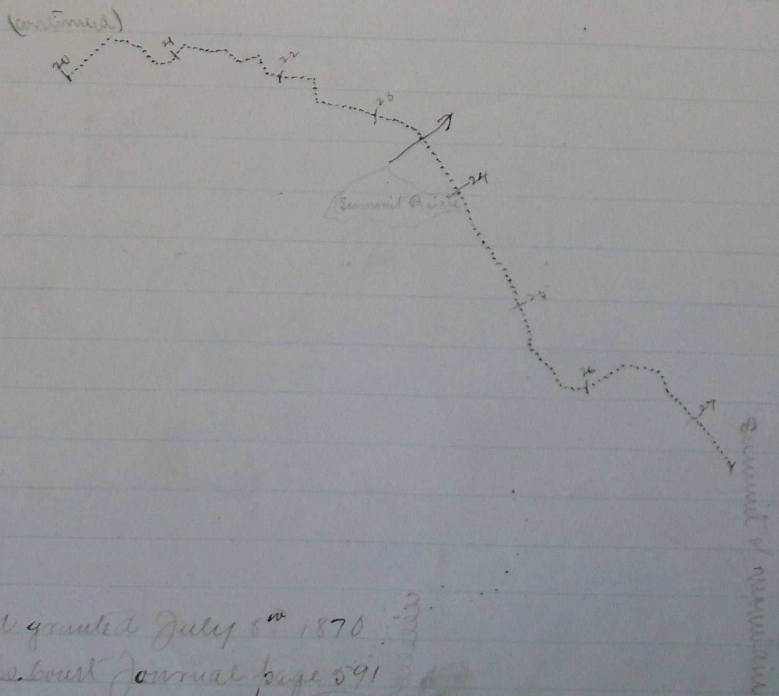


Rd #11
Plat of Road from State line
to
Blue Mountains
(continued)

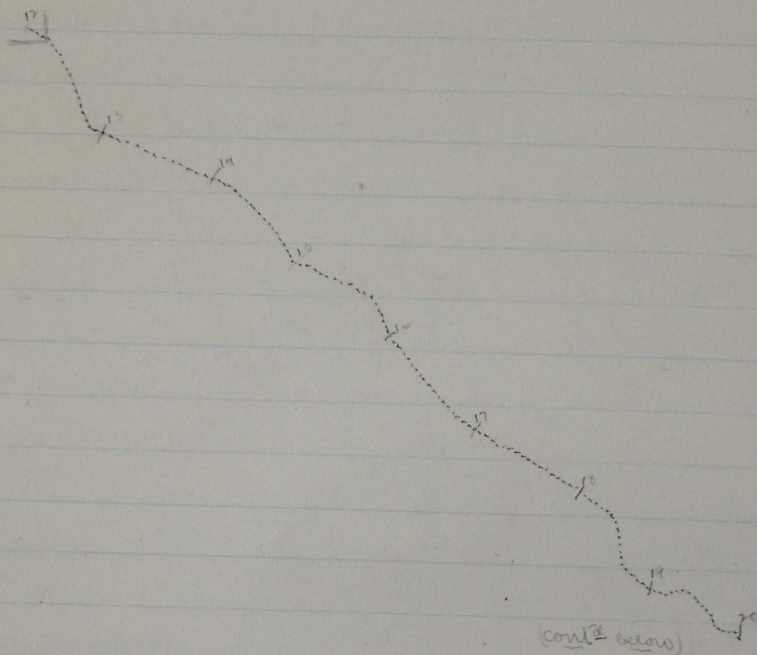

Road granted July 5th 1870
(See Laboult Journal page 591)