


Plot of Road from Weston

Rd #37

to  
Blue Mts.

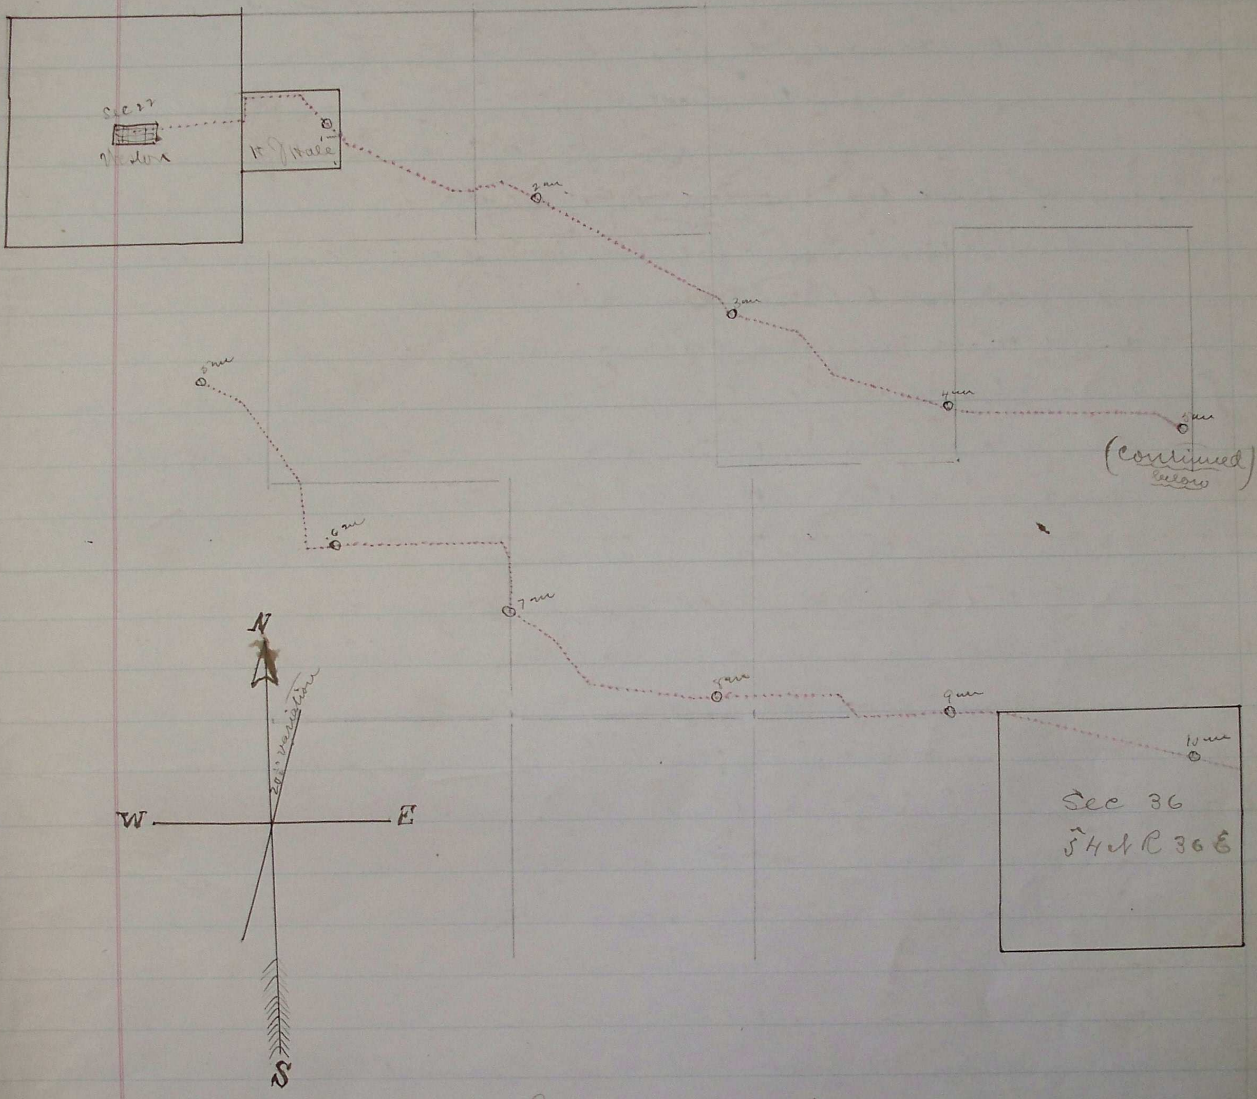

I certify that the above is a correct plot  
 of the road from Weston to Blue Mountains  
 as surveyed by October 22<sup>nd</sup> A.D. 1872 as per  
 Oregon at October Term 1872 accompanying  
 this are the field notes of the same

E. N. J. Scale  
 Chairman  
 J. A. Hartman

J. N. Sharon  
 County Surveyor  

Road granted and located Jan. 7<sup>th</sup> 1873  
 See Co. Court Journal "B" page 258