


Plot of land from Stansburys
to
Ollers Basin

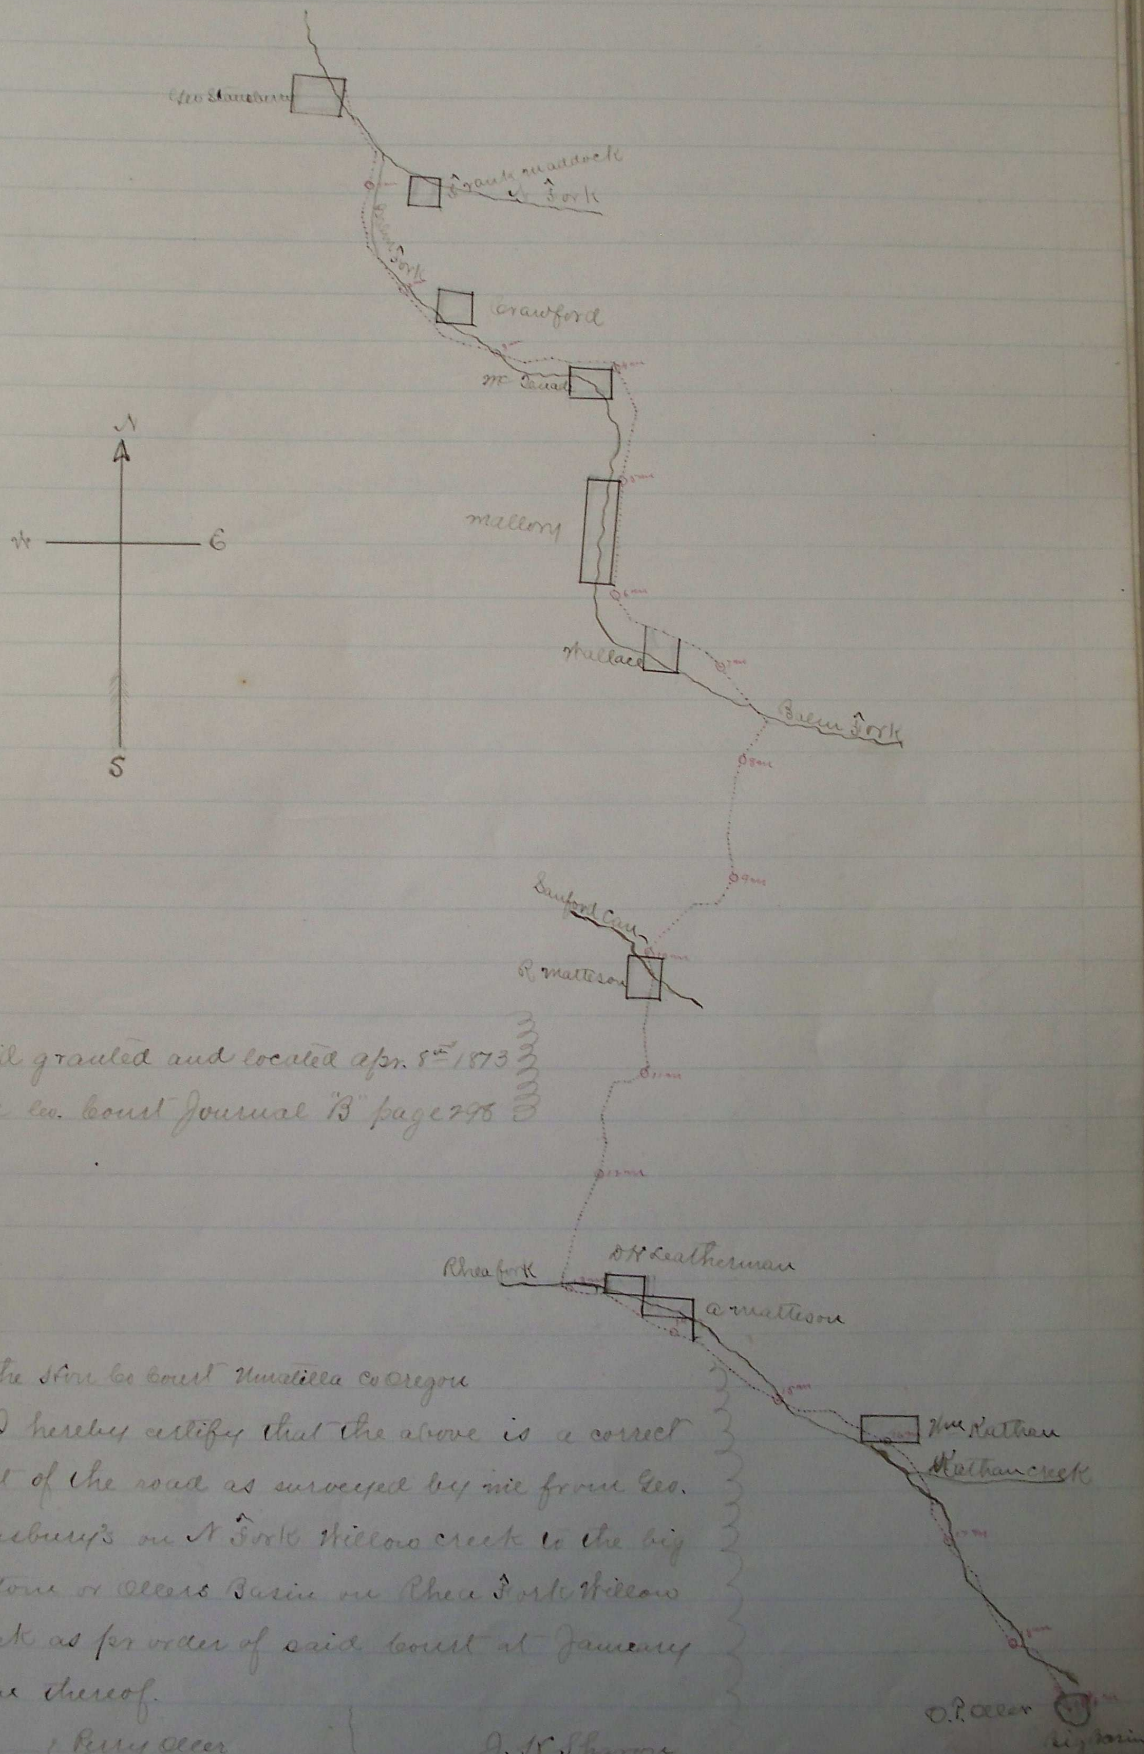

Road granted and located Apr. 5th 1873


I hereby certify that the above is a correct plot of the road as surveyed by me from Geo. Stansburys on N Fork Willows creek to the big Bottom or Ollers Basin on Rhoad Fork Willows creek as per order of said court at January term thereof.

Witness my hand and seal
 Perry Oller
 Robert Matteson

J. H. Sharpe
 County Surveyor

O. P. Allen
 Register