


Plan of Road from mouth of Rhea Cr.

33

C. Matison's Camp Blaine

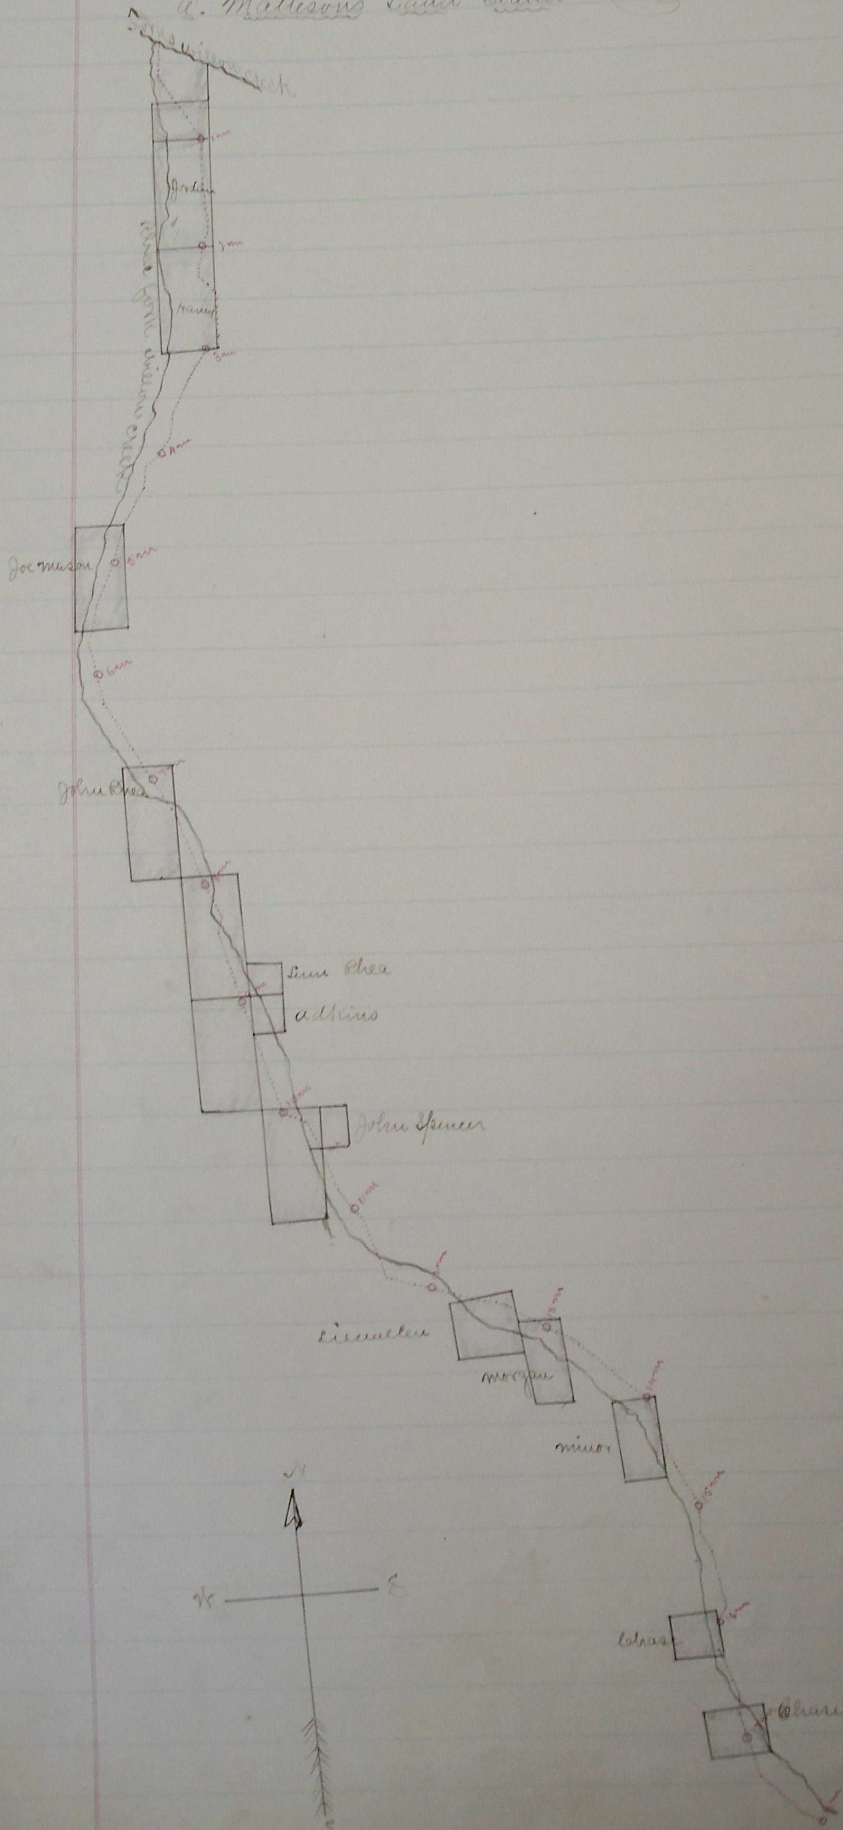

(continued page 46)