


Plat of Road from Jones & Cabals

Rd #32

to

Carney & Nelsons Cabin Blue mts

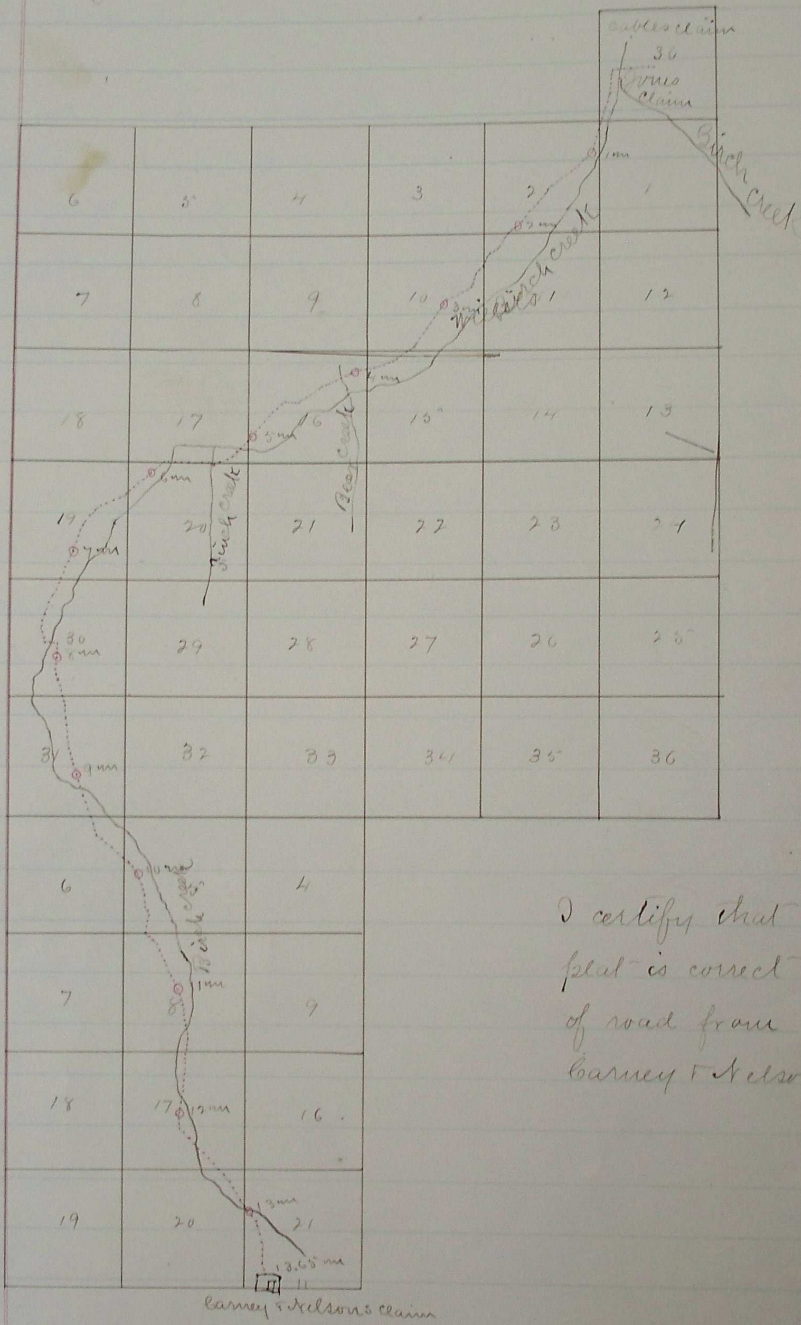

I certify that the accompanying
 plat is correct as surveyed by me
 of road from Jones & Cabals to
 Carney & Nelsons Cabin Blue mts
 J. W. Sharon
 Co Survey

Road granted and located Sept. 3rd 1873
 See Co. Court Journal 3rd page 355