


Plot of Road from Cables
Stuons mill

RD #29

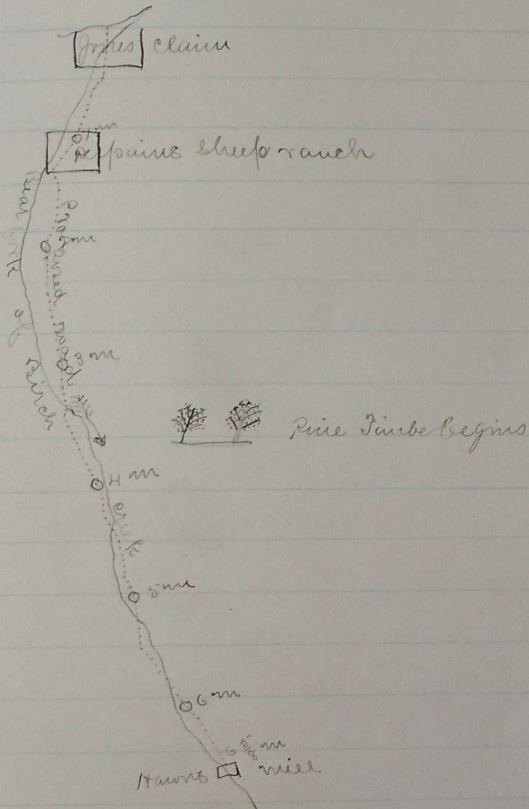

I certify that the above is a correct
plot of road from C. J. Cables to
Stuons mill as surveyed by me by
order of Co. Court at April term 1873

Chain bearers } B. J. Ogle
 } C. Cable

J. H. Sharon
Co Surveyor
Musilla Co Oga

Road granted and located July 5th 1873,
See Co. Court Journal 13th pages 830 & 836