


10 #36

Plan of Road from Linkton Road
to
Mountain Road

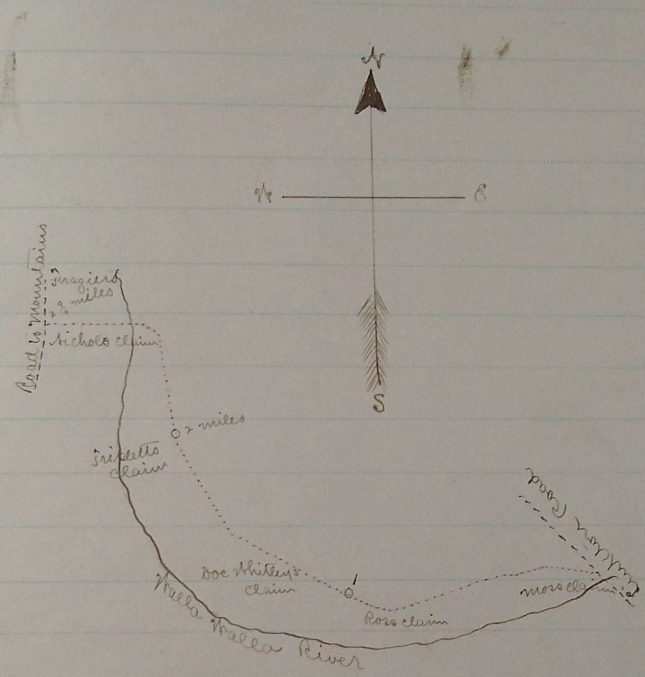

I certify the above is a correct plat of the road as surveyed by me from the Linkton road down Walla Walla River thence West between Nichols & Frazier to intersection of road running to Blue Mountains

J. N. Sharon
Co. Surveyor

Road granted and located July 9th 1874
See Co. Court Journal "B" page 436