


Plot of Road from near Geingers
to
5 m. above Forks Willow Creek

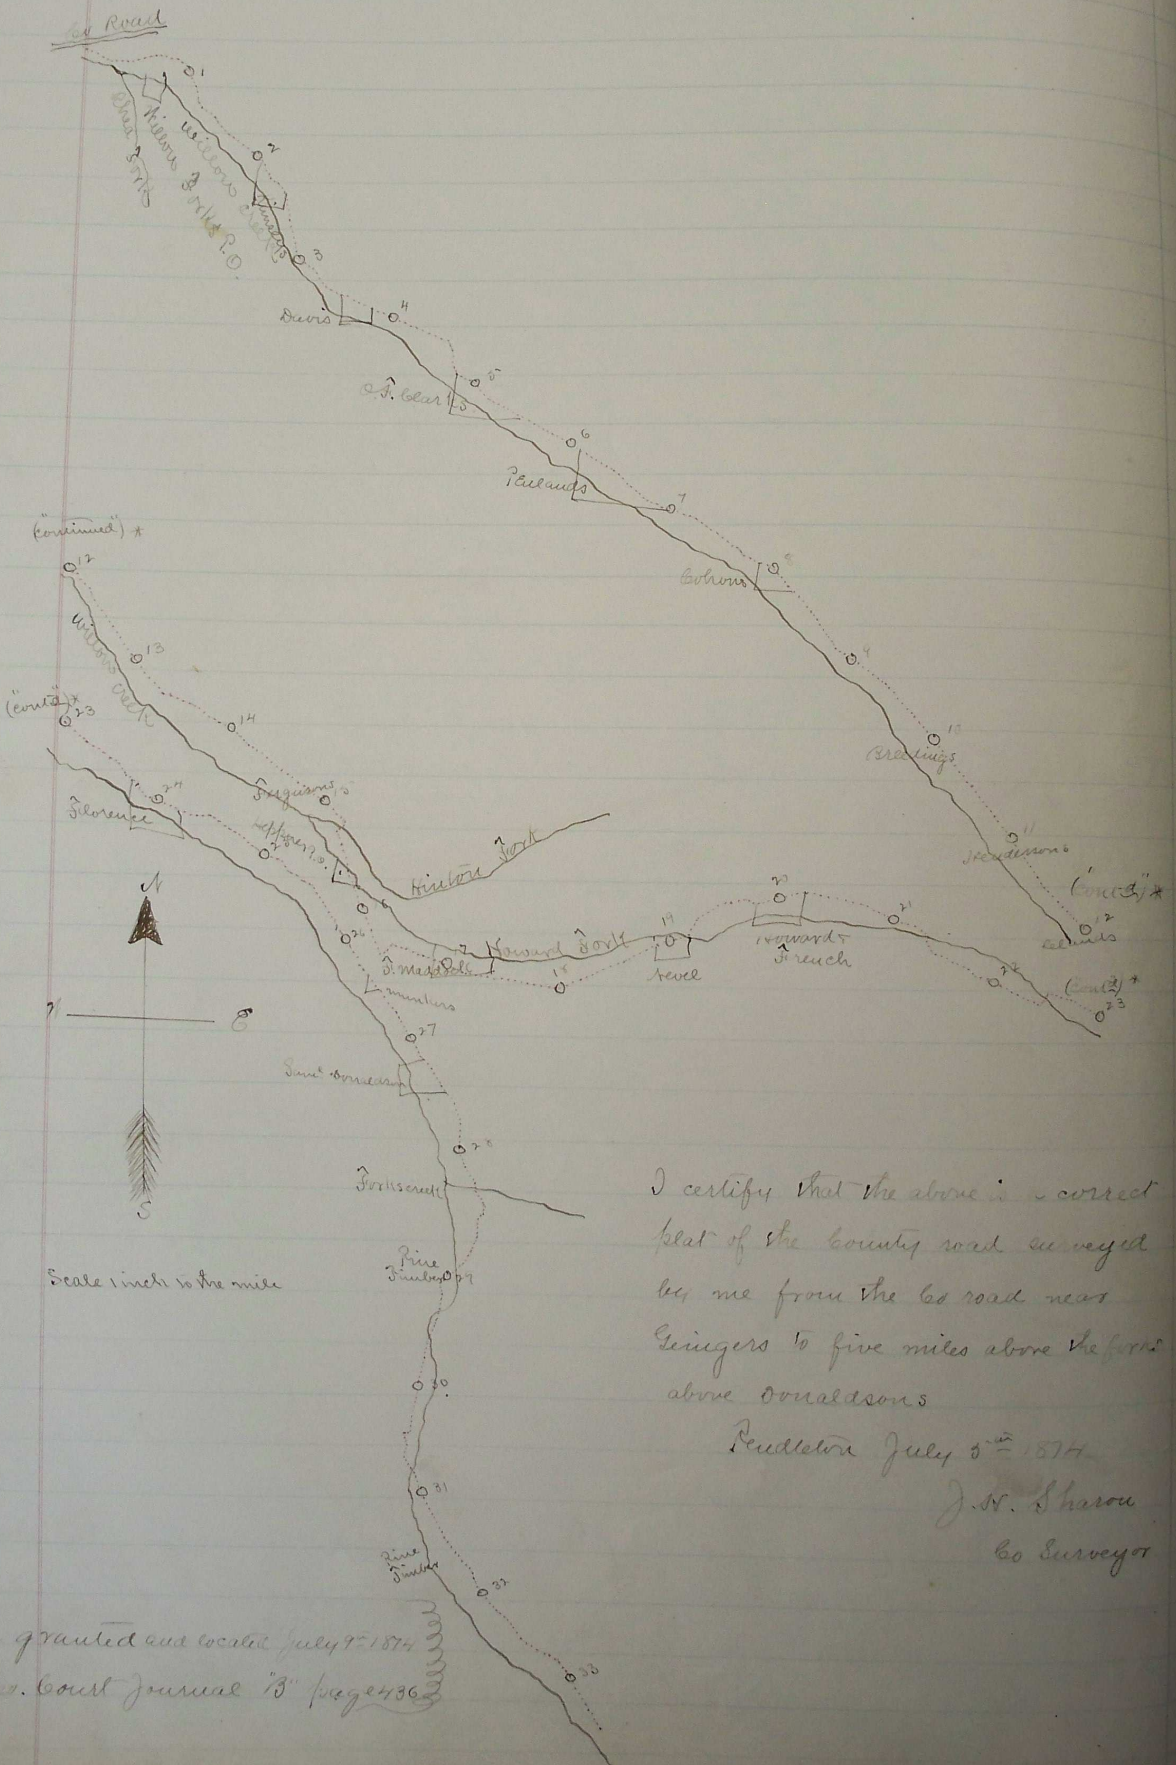

I certify that the above is a correct
plot of the county road surveyed
by me from the Co road near
Geingers to five miles above the fork
above Donaldsons

Pendleton July 5th 1874
J. W. Sharon
Co Surveyor

Road granted and located July 9th 1874
