


Plat of Road from Mc Duwils
 to
 Weston & W. W. Road near School House

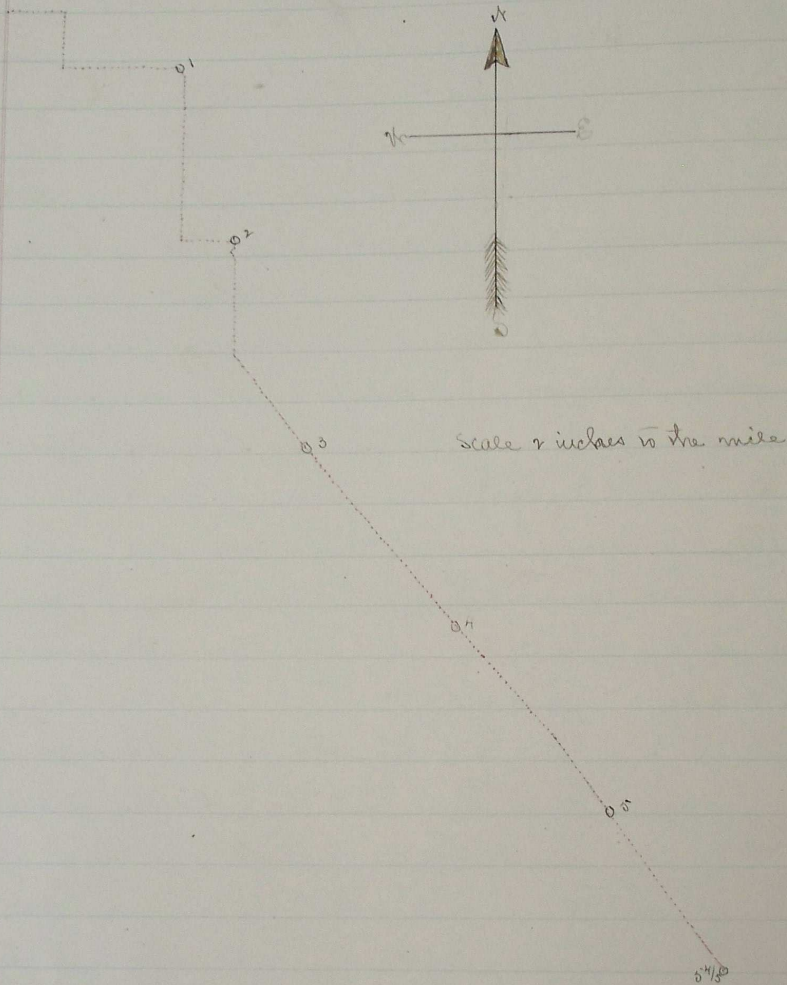

I certify the above is a correct plat of the
 road as surveyed by me from near Mc Duwils
 to the Weston and W. W. Road near
 the School House. J. S. Sharron
 Co Surveyor

Road granted and located July 9th 1874
 See Co. Court Journal B page 437