


2d #45

Flat of Road from ayers  
to  
Saw mill

(Continued)

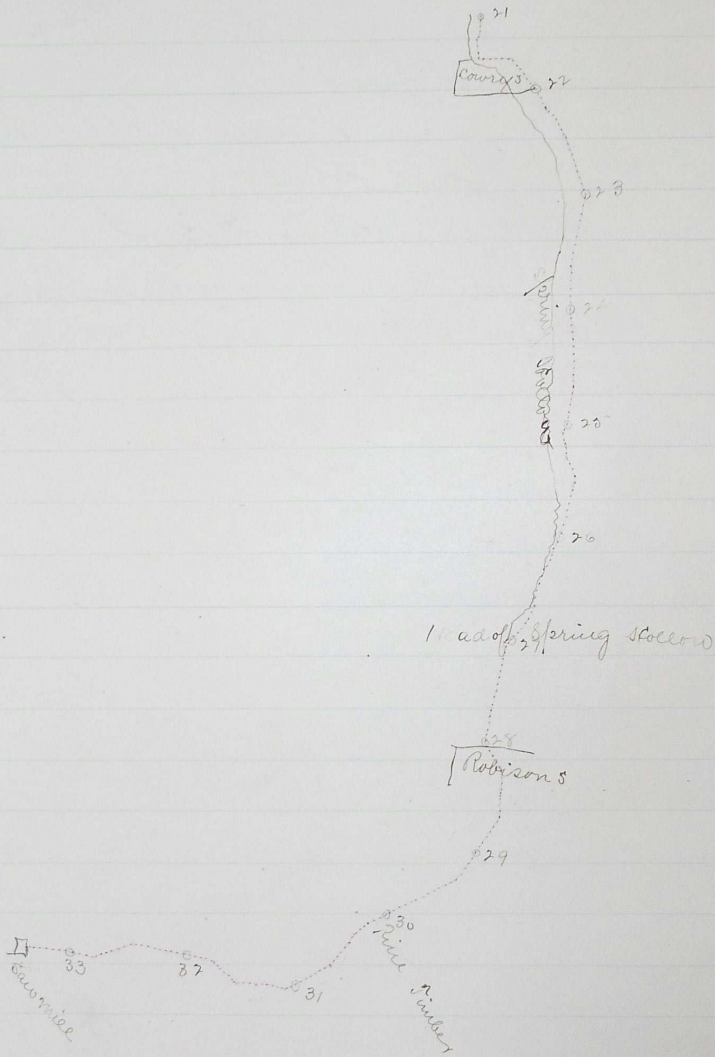

I certify that the above is a correct plat of  
 the road as surveyed by me from near  
 ayers to the Saw mill Surveyed Sept 29<sup>th</sup> 30<sup>th</sup>  
 & Oct 1<sup>st</sup> 27<sup>th</sup> 1874

J N Sharou  
 Co Surveyor  

Road granted and located Jan. 7<sup>th</sup> 1875  
 See Co. Court Journal "B" page 487