Plat of
Change in the County Road from Weston to Pendleton.

Rd #39

Road granted and located June 8th 1870.
See Co. Court Journal "B" page 273

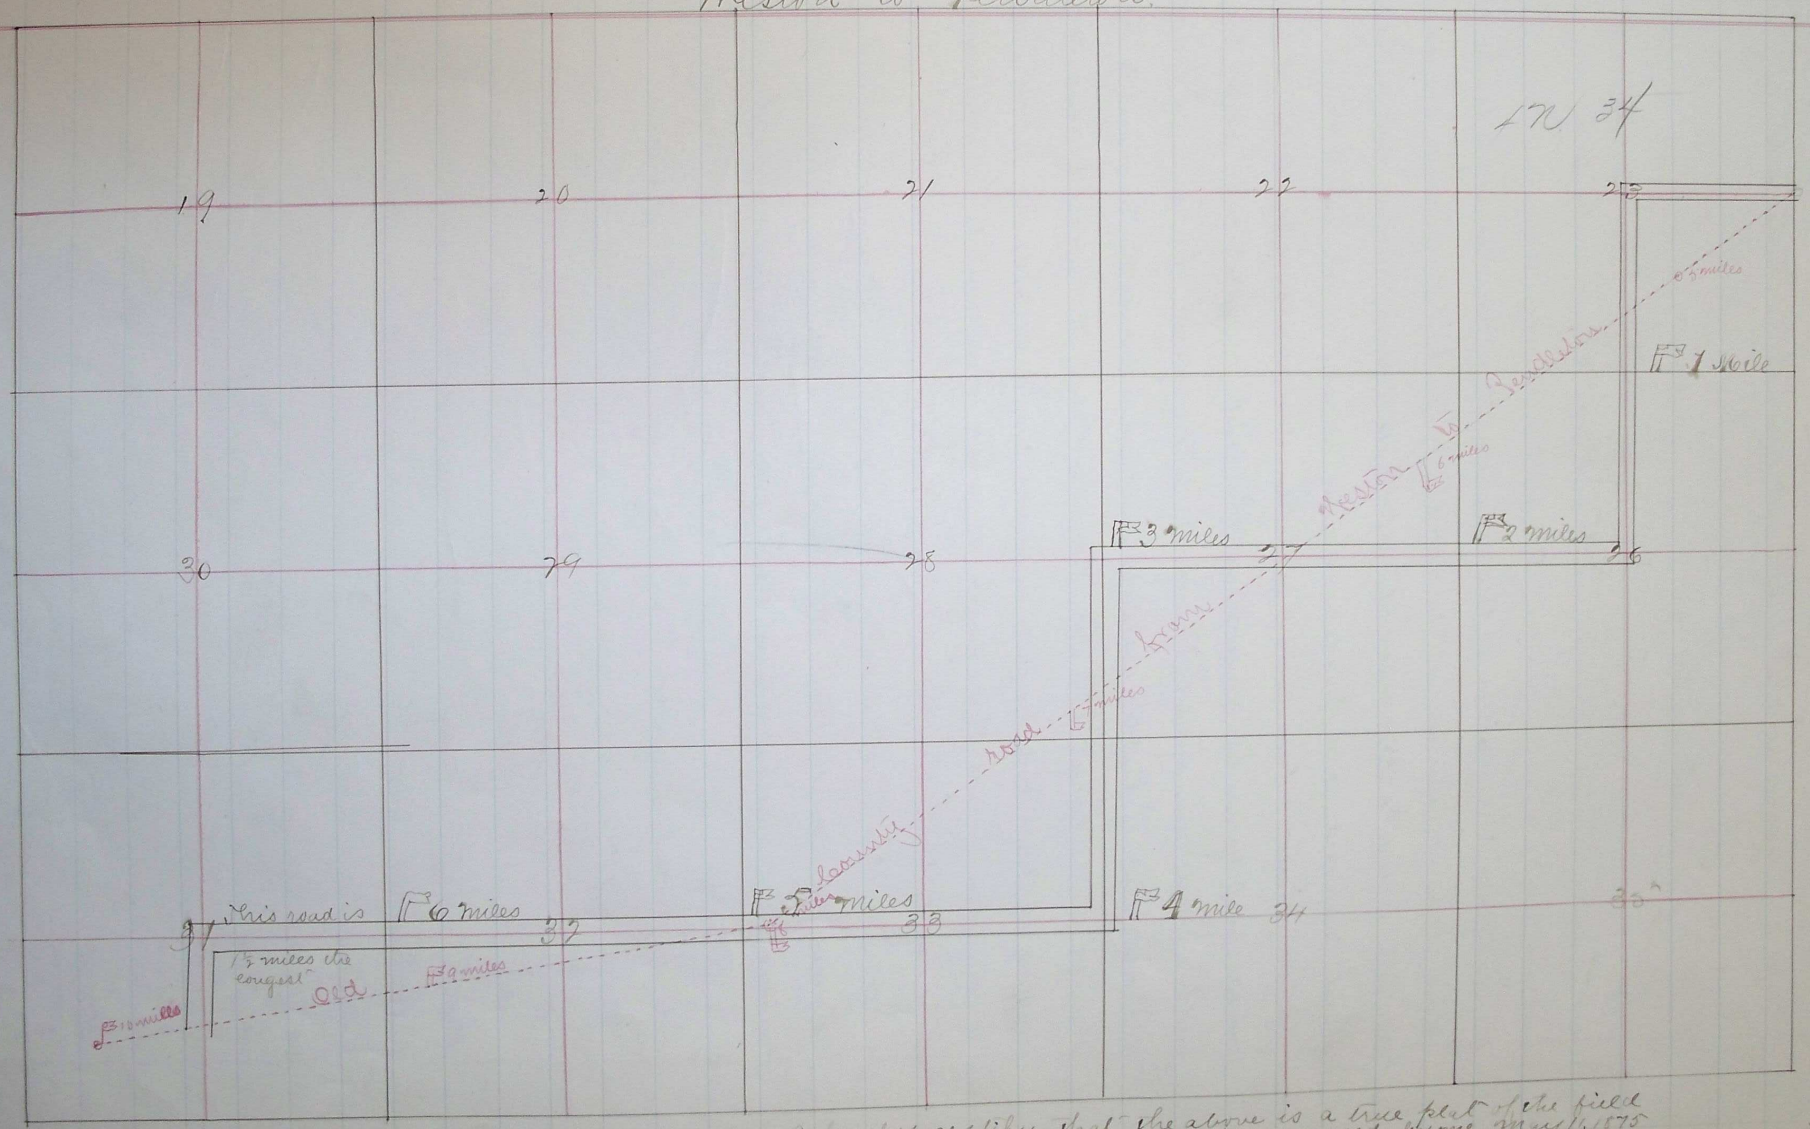

I hereby certify that the above is a true plat of the field notes of the above named road surveyed by me May 11, 1875

Pendleton May 15, 1875

J. R. Moorhouse
County Surveyor.