


Plot of County Road from Pierce's
Cand. claim to Clinton Road

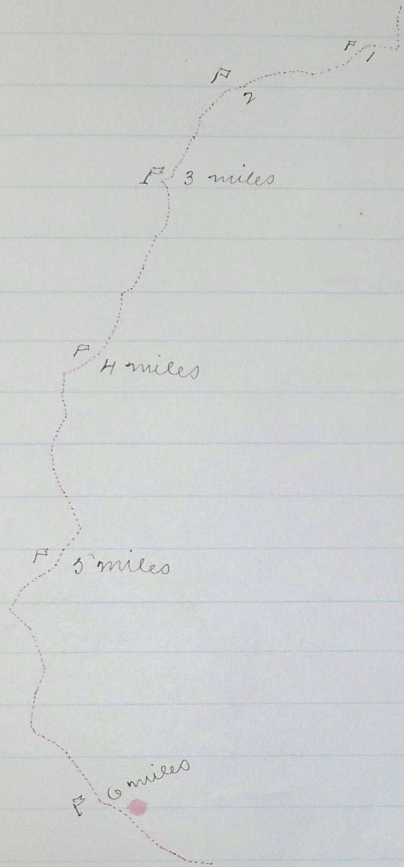

Road granted and located Sept. 9th 1875
 See Co. Court Journal "B" page 566