


ct # 43

Plat of County Road
from
1/4 miles North of Weston to Milton

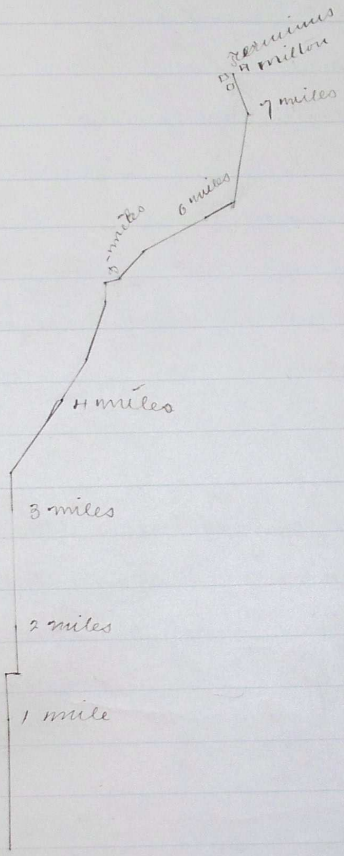

Surveyed Sept. 25 1875
J. C. Moorhouse
County Surveyor

Road granted and located Oct. 5th 1875
See Co. Court Journal "B" page 575