

Report Survey and Plat of Road from center Sec. 27 T. 4 N. R. 34 E.

Rd #42A

30

center Sec. 10.

To the Honorable County Court of Umatilla County Oregon
 In the matter of the location of a County Road commencing
 in the center of Sec. 27 Town 4 N Range 34 East and running
 north to center of Section 10 we the undersigned viewers submit
 the following report, We find the road be 3 miles long and it
 passes over a greatly undulating prairie it will not cost
 but very little to open it and we would recommend the
 same to be established as a County Road as we consider it
 to be Pro Bonus Publico

J. J. Kirk

J. L. Moorhouse

Field notes of Survey of County Road commencing at the
 center of Sec. 27 T. 4 N Range 34 E and running north to center
 of Section 10 Town 4 North Range 34 E Set a post for initial
 point thence north as per original survey

80.00 Set a post for 1 mile thence on same course
 81.00 " " " " 2 " " " center of section
 80.00 " " " " 3 " " " center of section


Town 4 North Range 34 E

Survey commenced and completed May 16th 1876

J. L. Moorhouse

Co Surveyor

Plat of Road from center of Sec 27 T. 4 N. R. 34 E

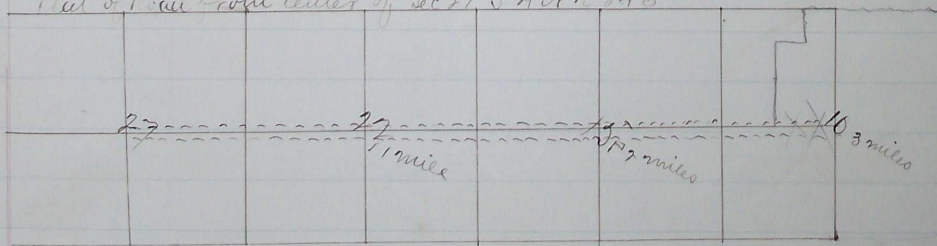

J. L. Moorhouse

Co Surveyor

Umatilla Co Or