


required size and correctly marked planted with mound four feet at the base and eighteen inches high and stakes marked A at every angle. The road commenced 8 rods west N.S. Gholsons land and ran 10 deg. west of South 34 rods then 15 deg. west of S. 94 rods then 25 deg. E. of S. 36 rods to point of hill then 10 deg. E. of S. 20 rods to foot of hill then 30 deg. E. of S. to 1 mile post then E. of S. 24 rods to angle then 25 E. of S. to School House in dist. no. 10 then 142 rods to top of hill then 5 deg. east of S. 8 rods then due S. between the land of N. Ford and J. M. Brockett 44 rods to mile post no 2 then S. 40 feet then due E. 80 rods then S. 7 1/2 miles then 10 deg. E. of S. E. 1 mile and 35 rods then 30 deg. E. of S. 176 rods to Milton.

(continued)

N. Fords land

foot of hill
J.M. Brockett's land

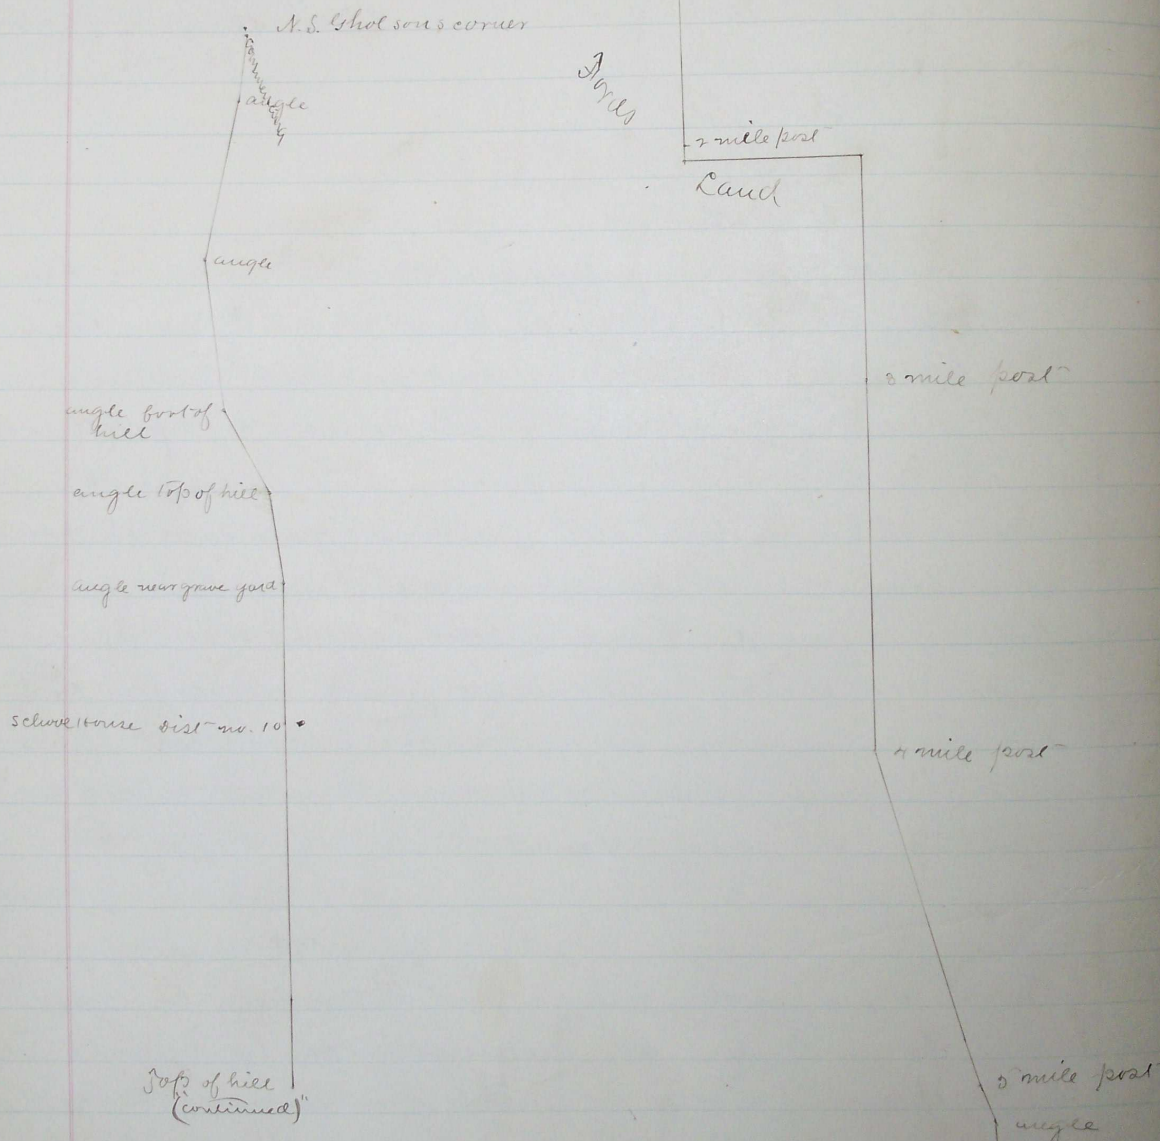

Land granted and located Sept. 6th 1877.
See Gov. Court Journal to page 126

Geo. J. Berry

Milton