

Rd #55

Report, Survey and Plat of Road from State Line
to
Intersect Mud Cr. Road


In the matter of the survey and location of a
County road commencing on the State Line between Oregon & ID
where said line crosses the line running N 1/2 through the center
of Sec 15 T 6 N R 35 E The your viewers beg leave report as
follows the land which said road passes over is nearly level
and the said road can be opened with a slight amt of work,
We consider that the road when opened will be of public benefit
and utility, and we would therefore recommend that the prayer
of the petitioners be granted and said road be established as a
County Road. Respectfully yours April 11th 1877

David Dealey Jr.
Joseph Vincent

Field Notes of Survey of County Road commencing at State
line and running South through the center of Sec 15 T 6 N
R 35 E to the intersection of the Mud Creek Road,

- Set a post for initial point thence
South
- 36.50 point thence
West
- 29.50 point thence
S 20 E
- 14.00 Set a post for 1 mile thence same course
- 16.50 point thence
S 52 1/2 W
- 20.00 Intersect Mud Creek Road at 1 mile post

Survey commenced and completed April 12 1877

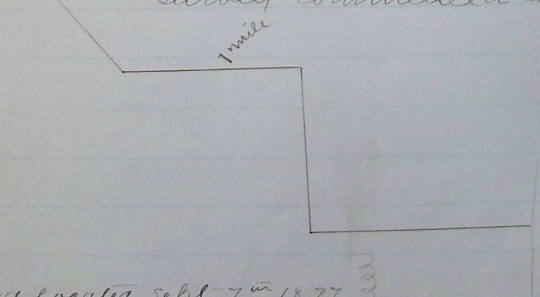

J L Moorhouse, Surveyor
Map of County Road com-
mencing at State Line and
running to intersection
of Mud Creek Road

Road granted and located Sept. 7th 1877
See Rev. Correll Journal "D" page 131