


Rd #63

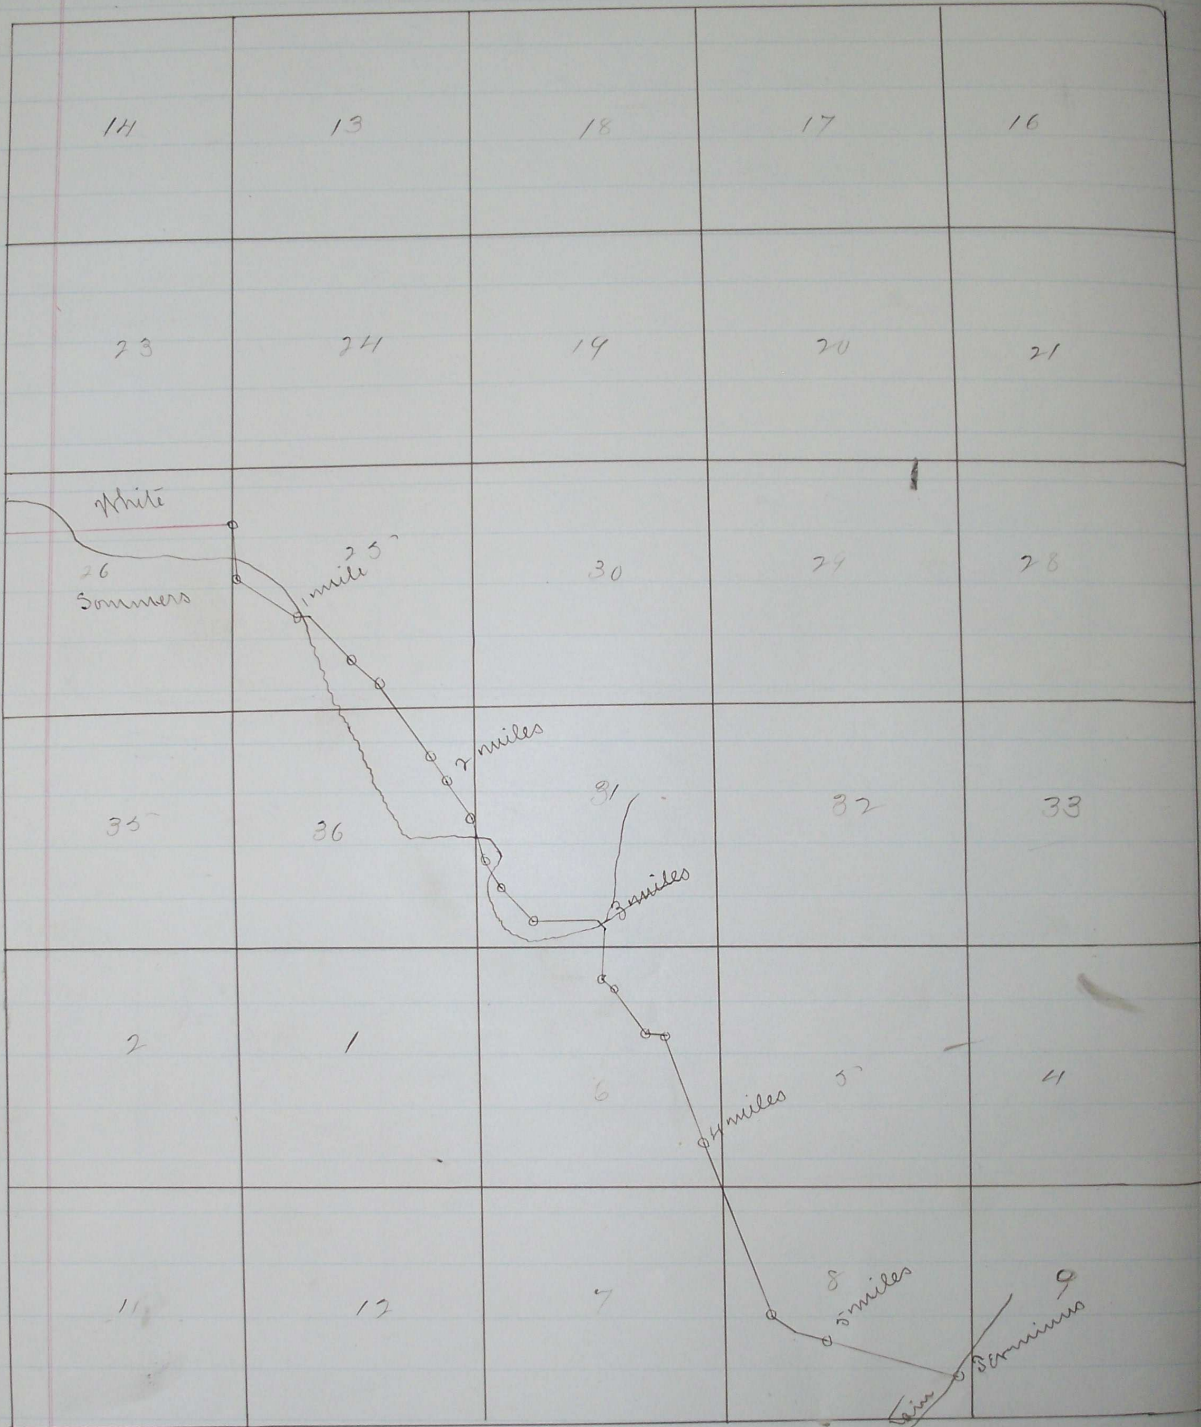

Part of County Road commencing on line bet Sommers & White
and running up Birch creek to Government Mountain
Surveyed Feb'y 21-78

J L Moochouse
Sur

2 Roads granted Locuste March 6th 1878
See Co. Court Journal 6th page 177