


Map of change in Upper Siskiyew Road

(Continued)

Rd #C-1

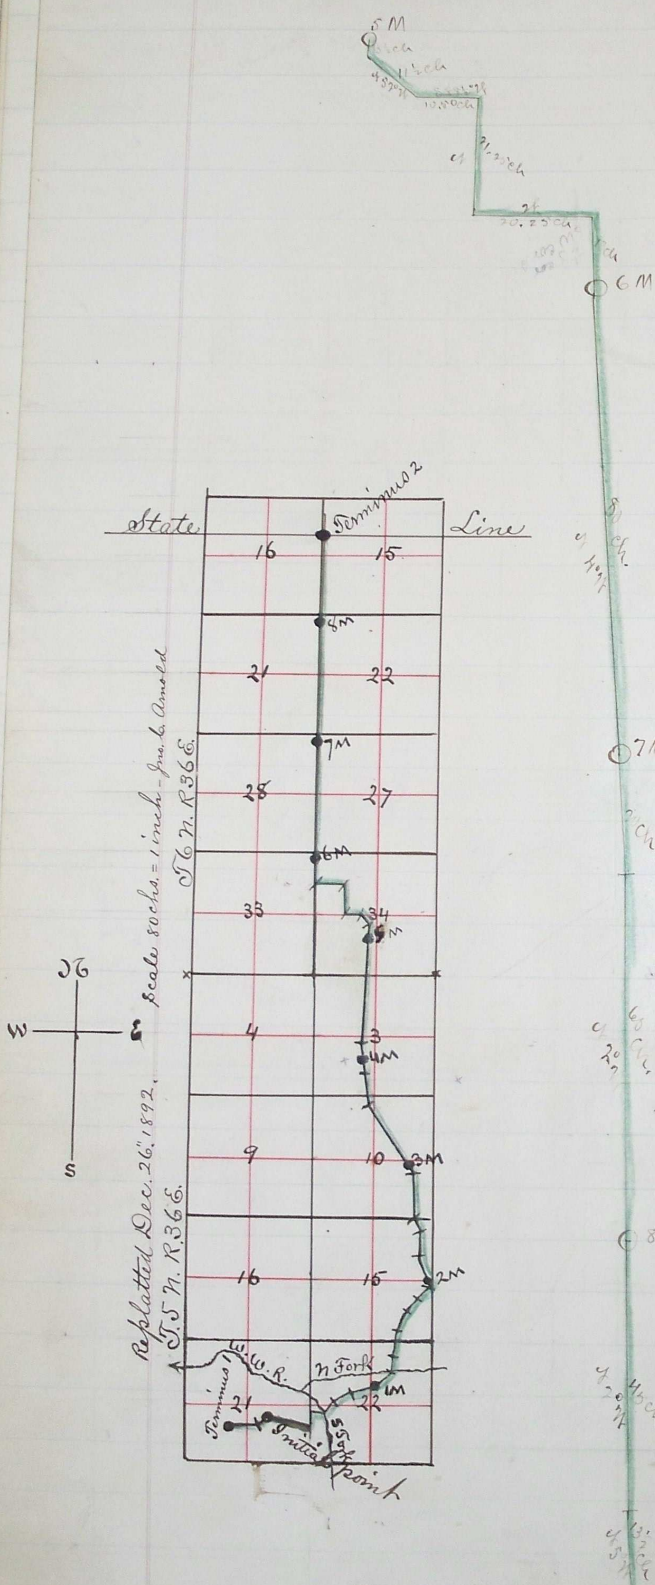

Scale 80 chs = 1 inch - J. & A. Arnold
J.S. N. R. 36 E.
Replatted Dec. 26, 1892.
J.S. N. R. 36 E.

J. C. Arnold
Surveyor

viewers } J. L. Keser
 } Thos J. Weaga

chain } L. Bocolus
bearers } R. M. Corlthy

marker } Jas. Lawrence

road graded and located Sept. 5th 1876
See Co. Court Journal "C" pages 216 & 217