


Rd # C-1

Plan of Road from Hudson Bay to

Milton

Plan of within described road commenced Monday May 13 and completed Tuesday May 14 A.D. 1878.

The bearings were taken with a common compass graduated only to degrees & the day on which the road was run quite cloudy, so that the bearings are approximately correct
 var. of needle taken to be at 70° E

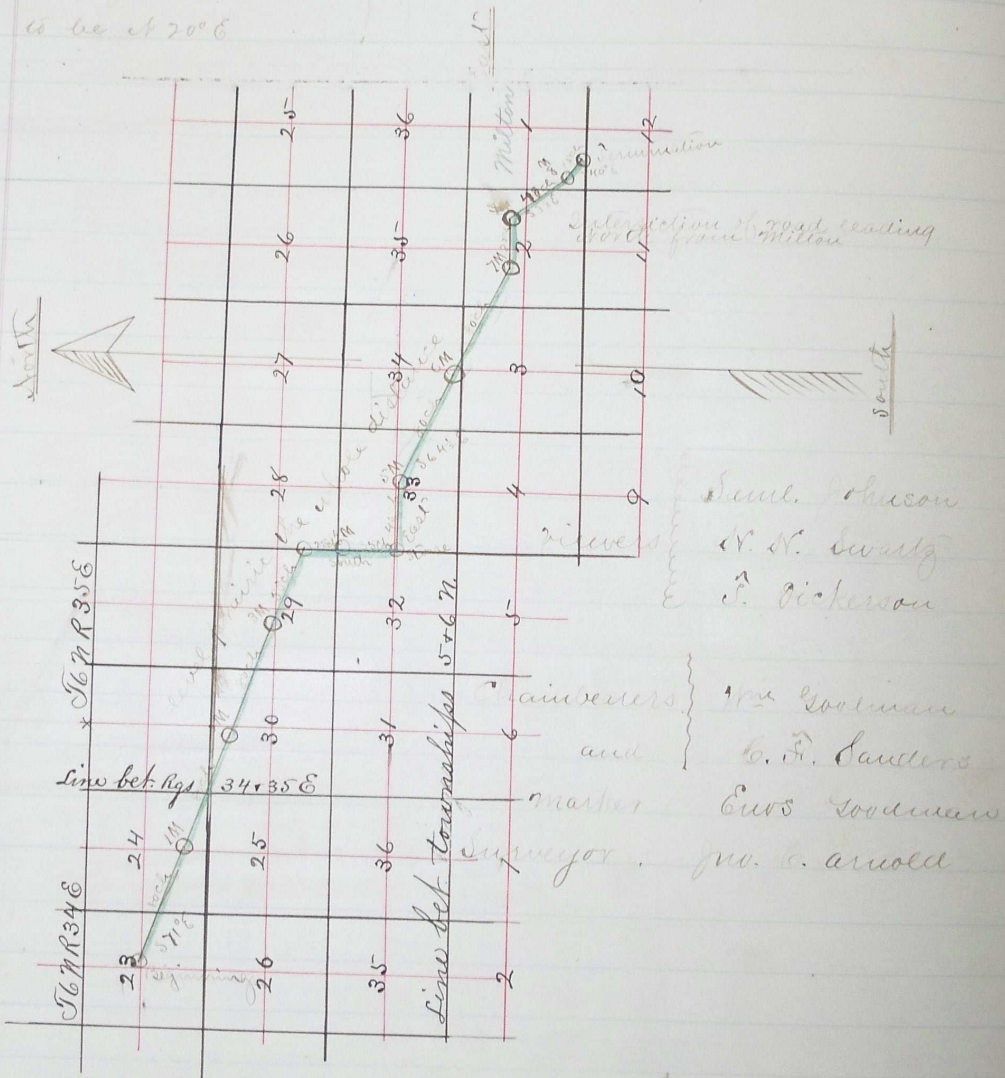

Road granted and located Sept. 5th 1878
 See Gov. Court Journal "6" page 718