


Rd #38-A

Plat as per survey and report
 on order of change in Walla
 Walla and Wild Horse County
 Road, Executed Sept. 14th 1878
 Wmatilla Co. } Jas. H. Haley
 Oregon } Geo. Harvey

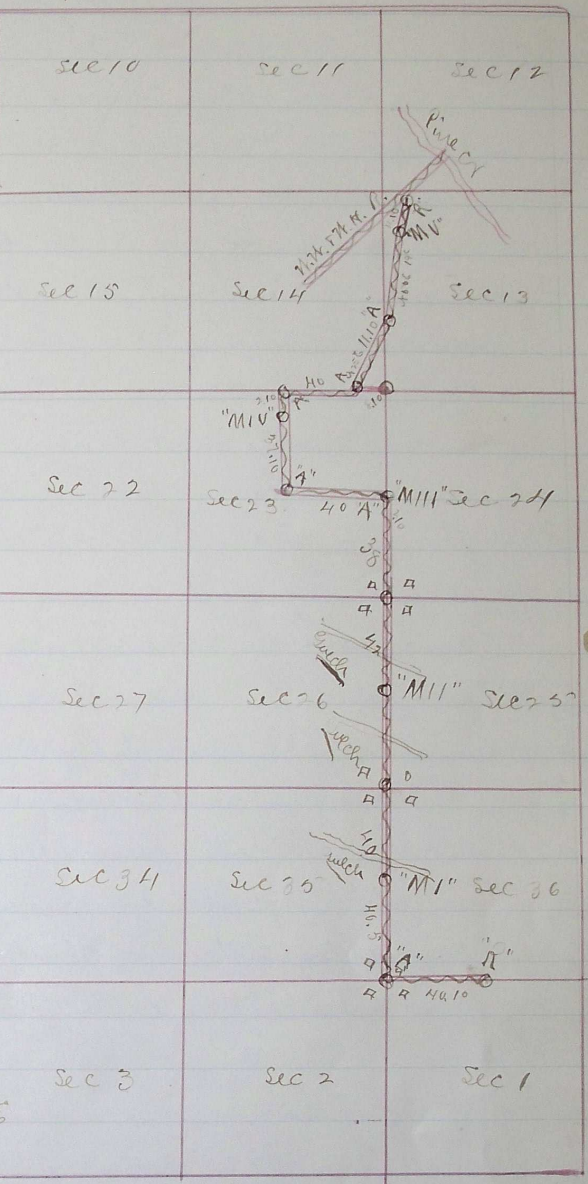

98

6

5

Journal D 270

Road granted and located Jan. 9th 1879.
 See Gov. Court Journal "6" page 270