Rd #59

Plat of Road from State Line
To
Blue Mountains
(Continued)

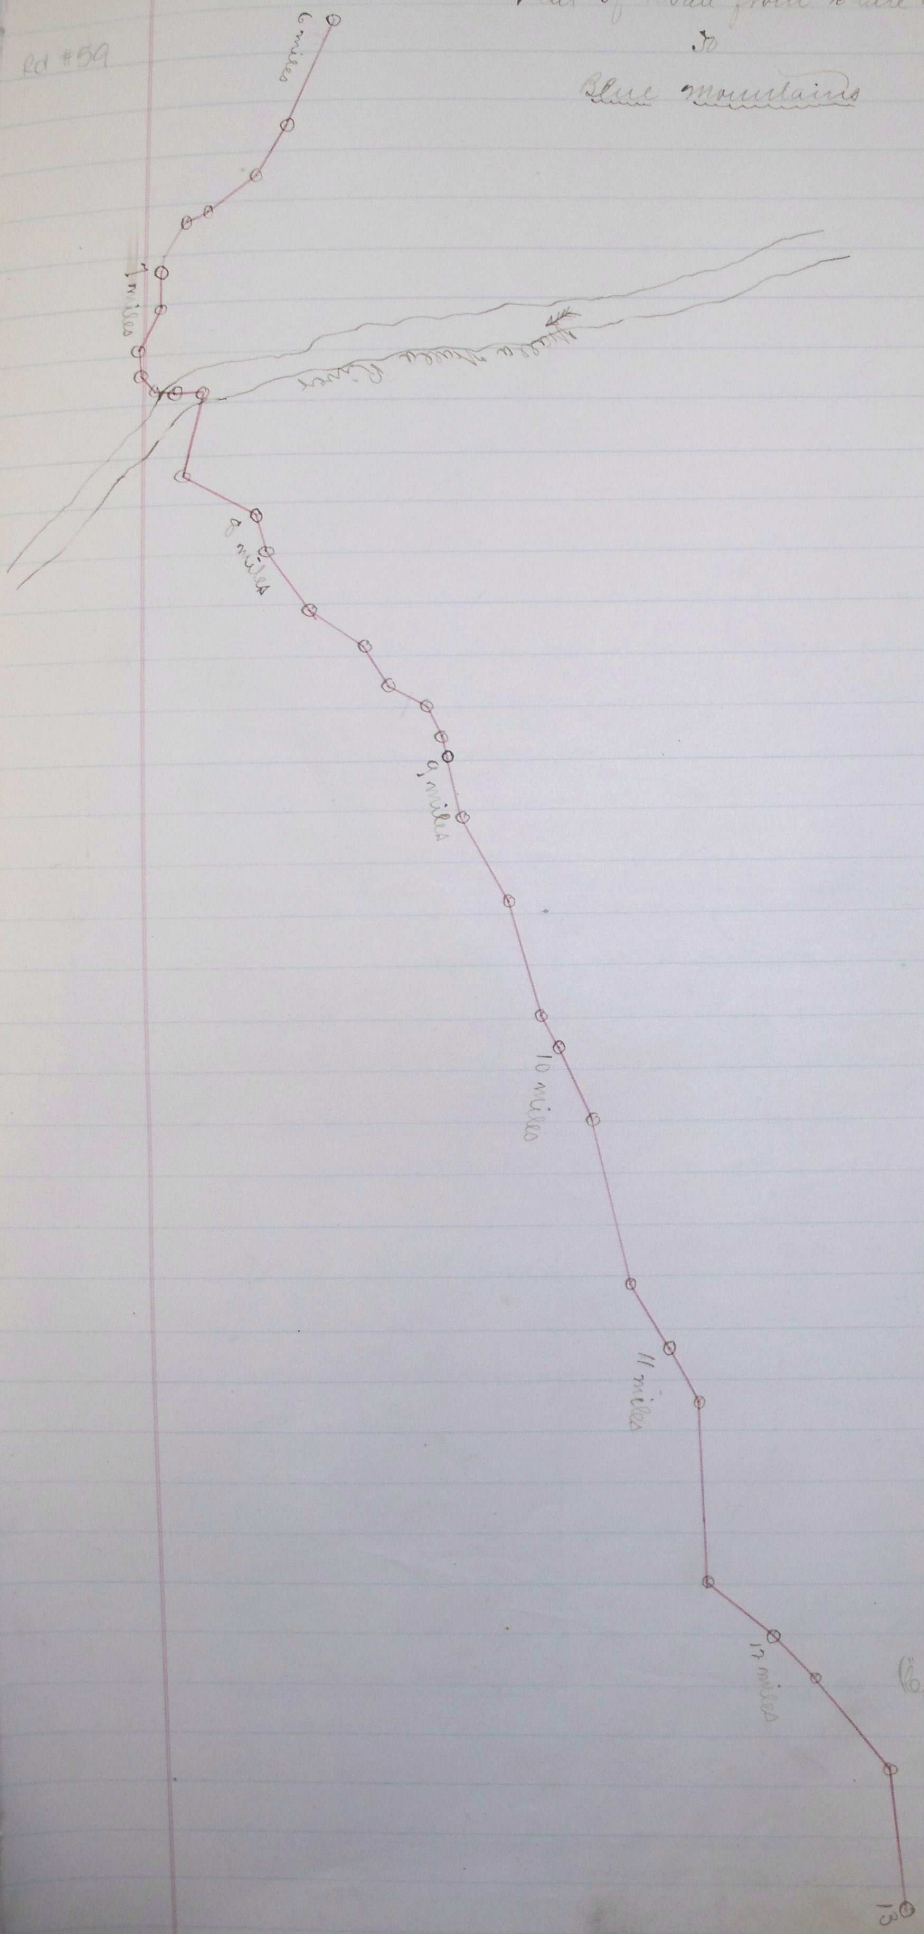

(Continued p. 124)