

Rd #128-A

Report, Survey and Plat of Road from O'Harra Gulch

Heston and Summerville Road.

Pendleton Dec 26th 1876

Gentlemen: Having viewed and noted the survey made on the within petitioned road we beg leave to report the proposed road as a favorable and practicable one and recommend its adoption.

J. B. Purdy

William Russell

Per O. O. Benson

Deputy Co. Surveyor

Field Notes.


Commenced at thorn bush at mouth of O'Harra Gulch marked same for beginning of road. From thence run in a south easterly direction as marked on the attached plat. Marked each successive mile by legal posts, also set angle posts at the several angles, until arriving at Heston and Summerville road named in petition. From thence following said road a distance of 5 miles and 5 chains marking each mile but not noting angles. At termination of road set post marked "R" also marked "M X 1" denoting the length of survey.

J. B. Purdy } viewers
Wm Russell }

J. H. Raley Surveyor

Per O. O. Benson Deputy

Executed as per order made by Court on 4th day of Sept. 1876

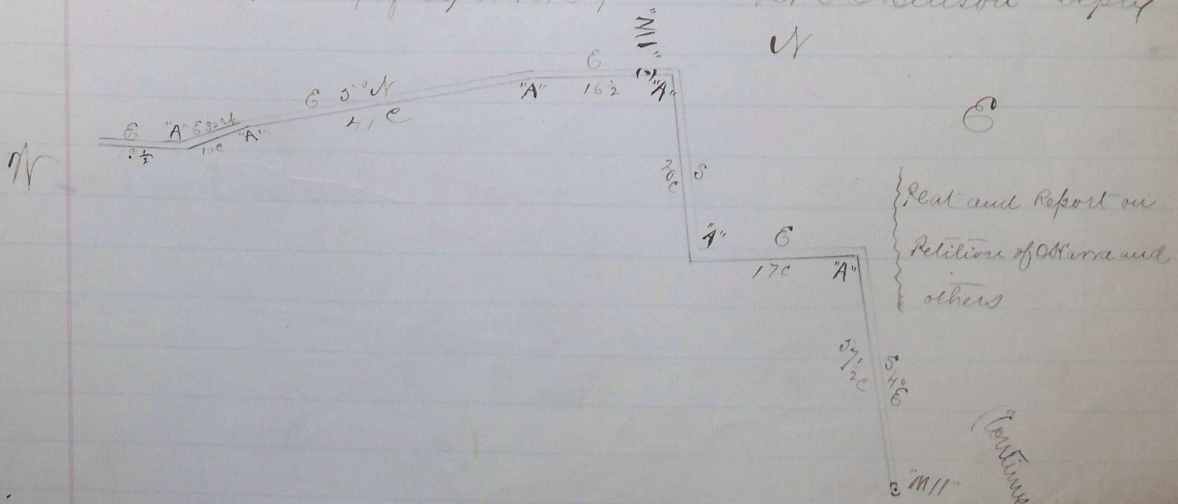

(Continued p. 128)