


Plot of Road from O'Hara Gulch

Rd # 129-N

In

(Continued)

Weston & Summerville Road

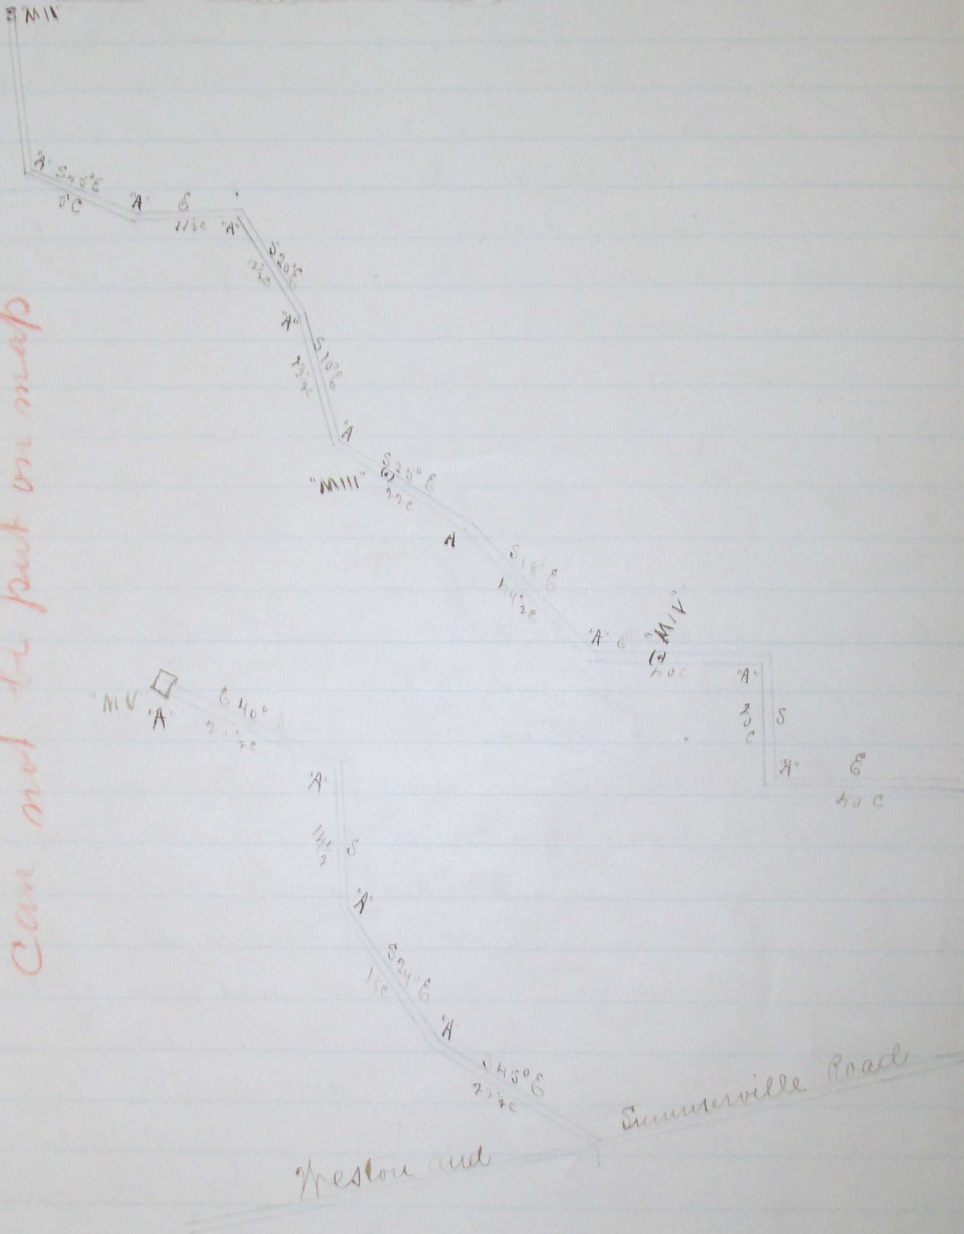

Cloud granted and located Jan. 9<sup>th</sup> 1879  
 See Co. Court Journal "6" page 272

Journal 19272