Rd Rd #144-A

Plat of Road from W. H. Creek to Weston and Charleston Road

Rd # 1

N.

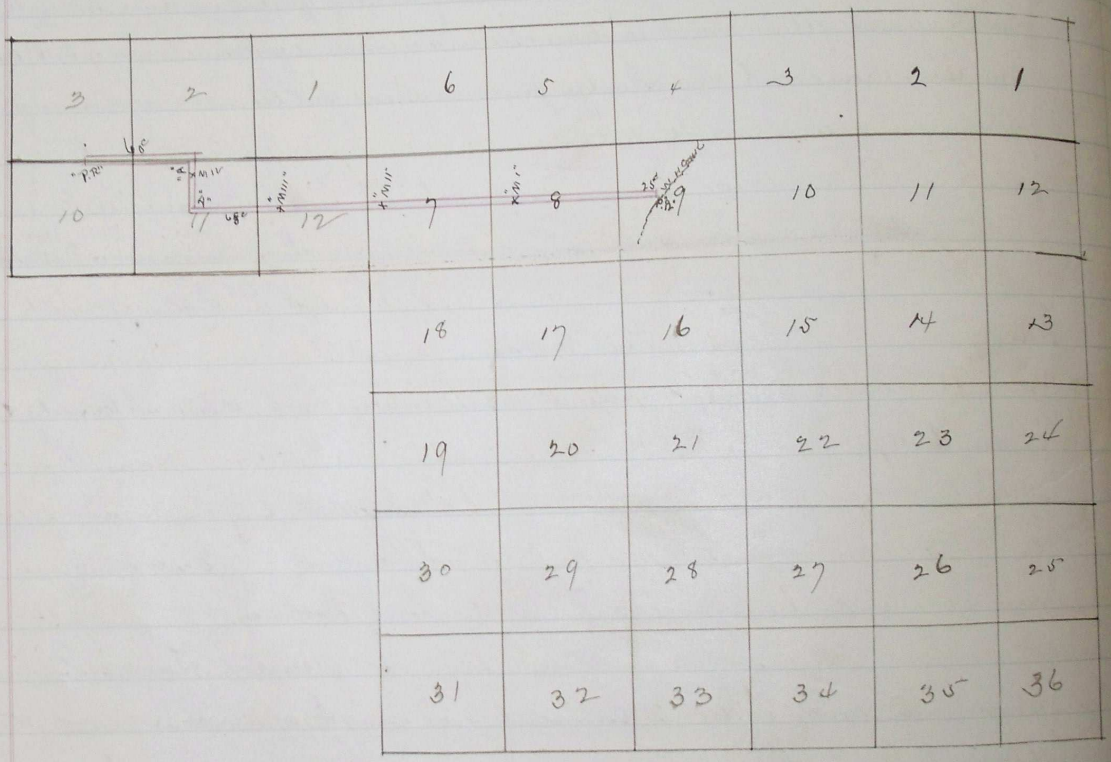

3	2	1	6	5	4	3	2	1
10	11	12	7	8	9	10	11	12
			18	17	16	15	14	13
			19	20	21	22	23	24
			30	29	28	27	26	25
			31	32	33	34	35	36

S

Filed for Record April 9th 1879. Recorded May 7th 1879.

Road granted & located April 10th 1879
See Co Court Journal "C" Page 328