

Rd # 1

Starting point to South Eastern Terminal

Aggregate of Sounding 38⁴⁶/₁₀₀ miles


" Easting 36⁵⁹/₁₀₀ "

At the end of Every mile we set a Stake not less than four inches square duly marked by cutting the figures at least a fourth of an inch in depth. Said Stakes being driven eighteen inches deep & remaining from two feet to two feet six inches above ground.

I hereby certify that the foregoing survey & field notes as set forth in this report were duly made by me in pursuance to an Order of the County Court, directed to me by the Clerk of said County Court & that the same is true & correct.

Dec 30 1865.

E. A. Wilson, County Surveyor

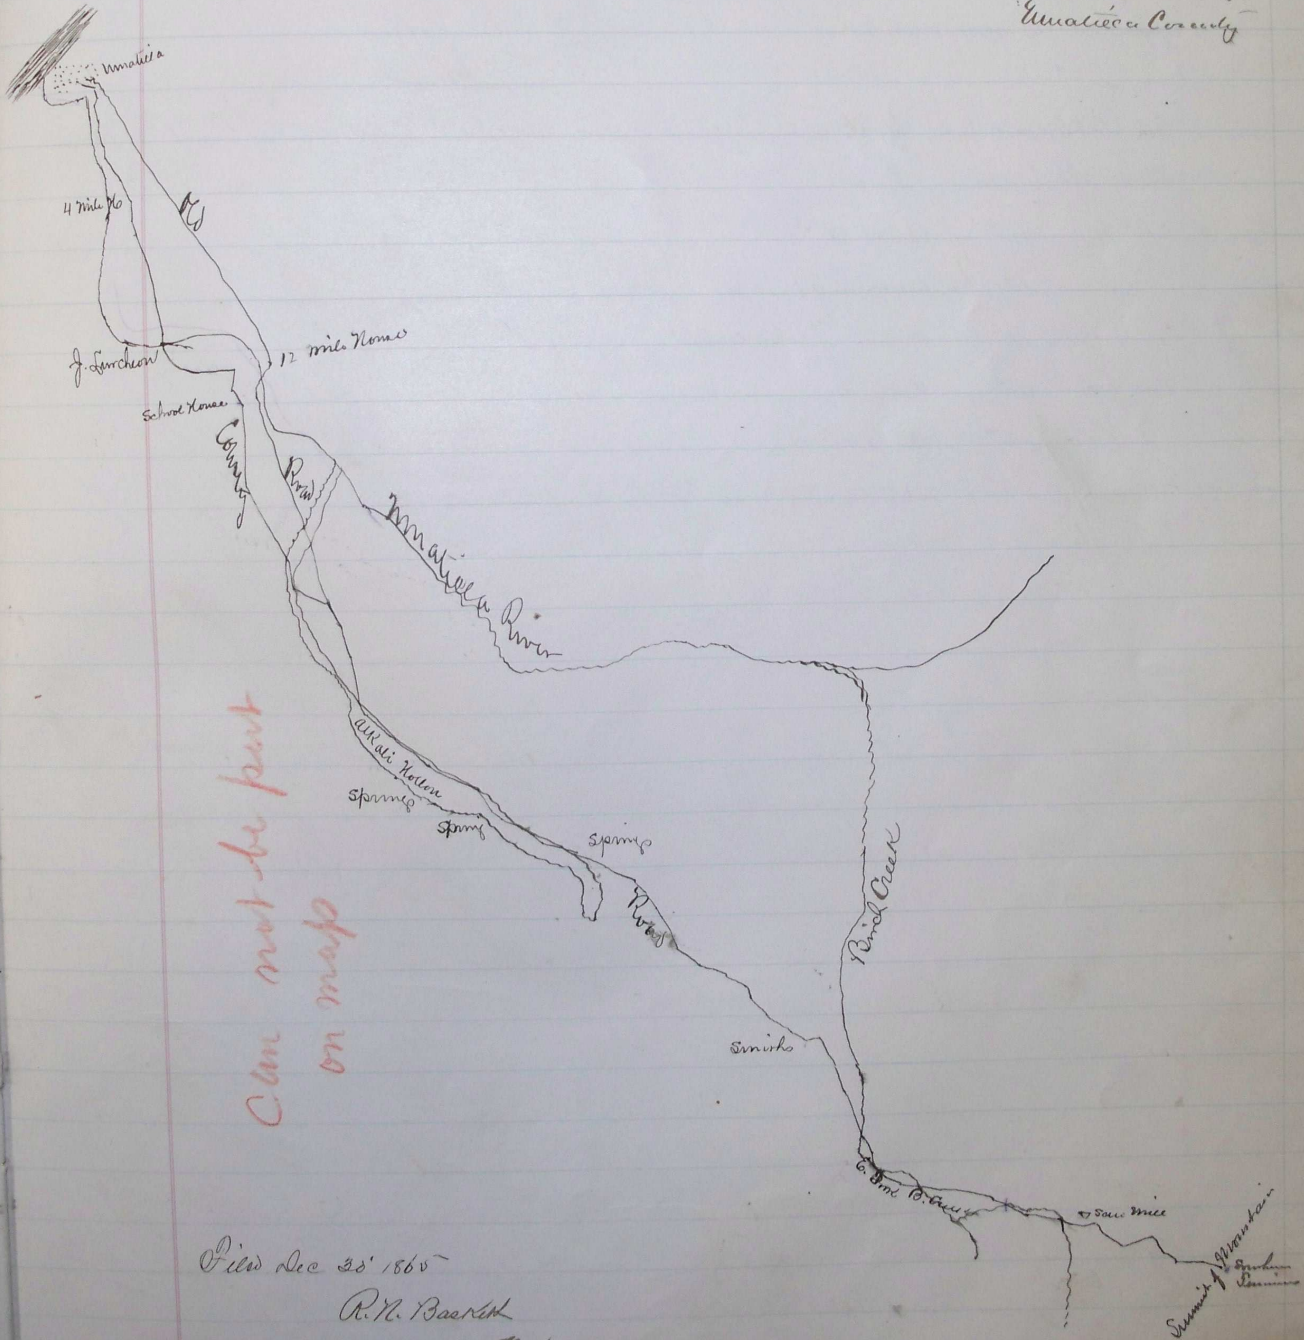


R. N. Baerth

CK

Matilla
by the
to home