


Not County

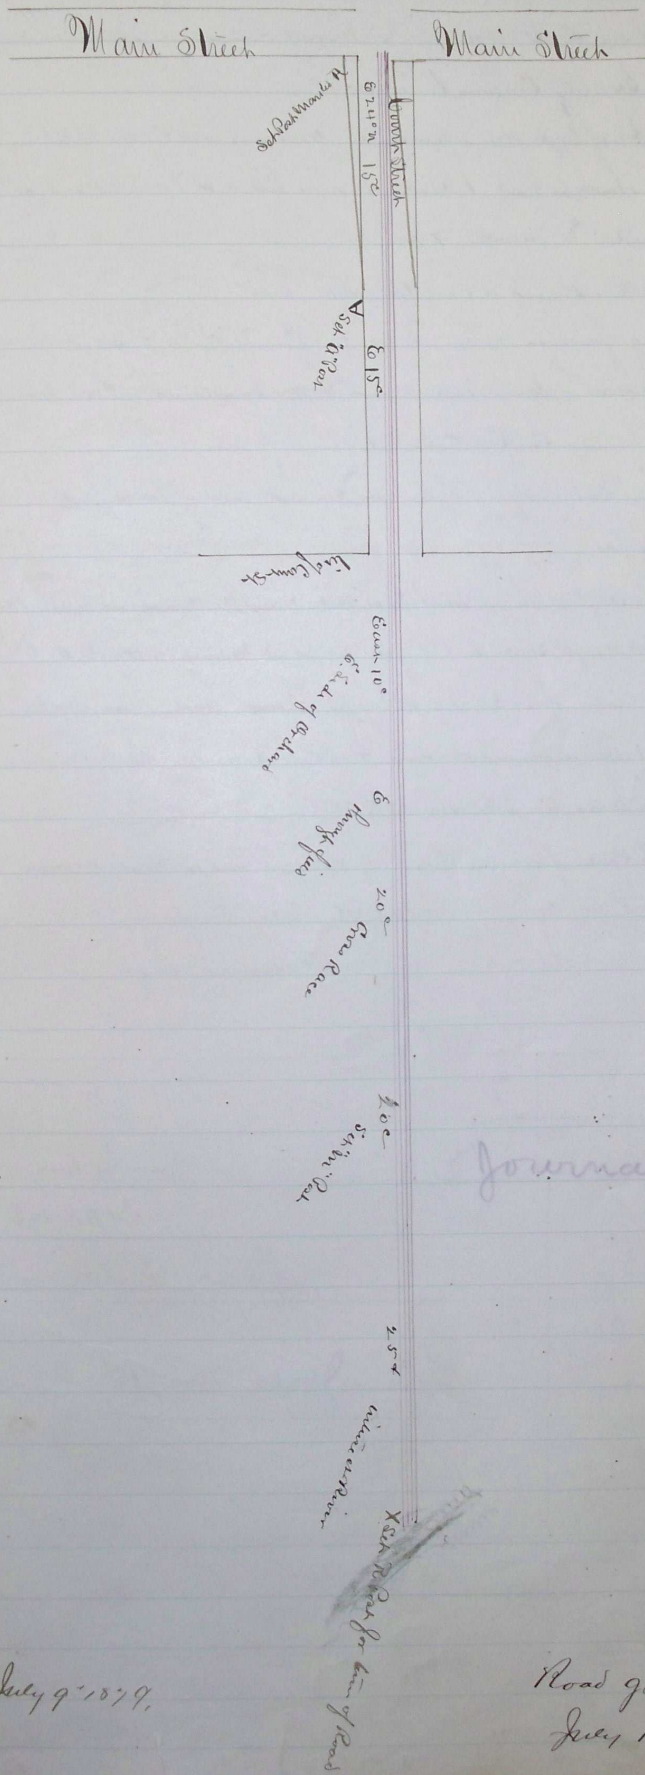

Journal 19. 383.

Died July 9, 1879.

Road granted + located
July 11, 1879