Rd #34-A

34/E.

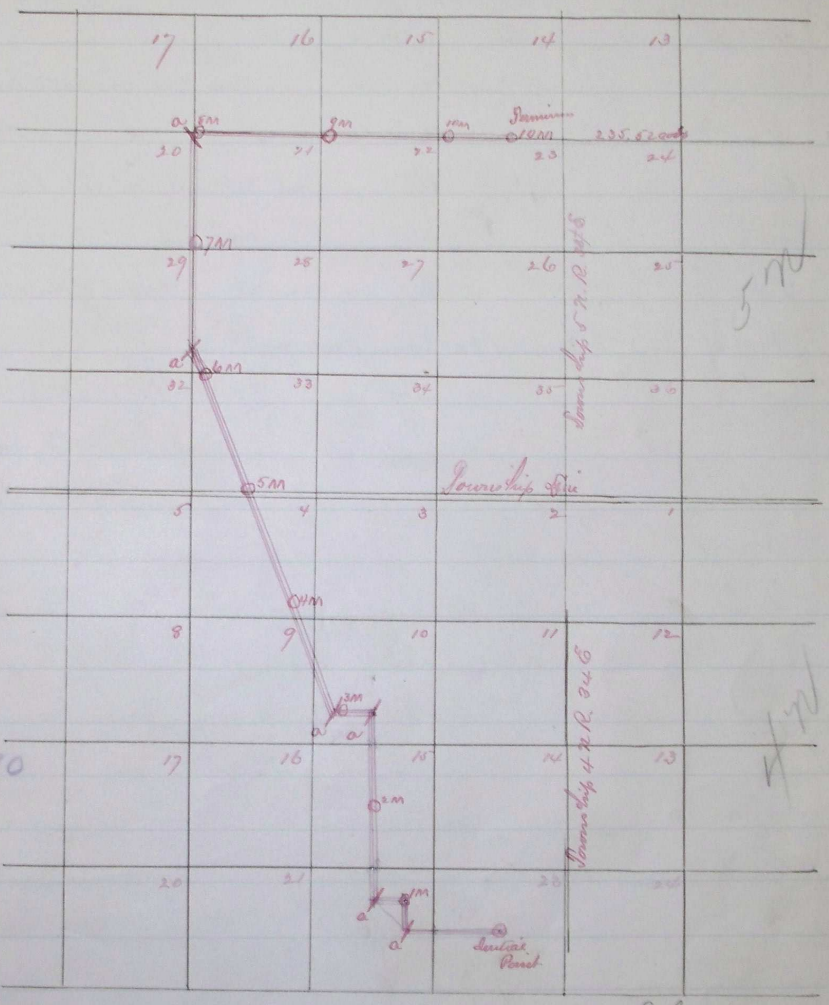

Journal, P. 380

John C Arnold Dept Surveyor

To the Hon: Co: Court of Umatilla County Oregon

We A.R. Price & H.J. Hale appointed at the April Term of your Honorable Court as viewers of the within described road which we have carefully examined & know to be true, report favorably on the same & in our opinion the road will be of great practical utility & are much needed in the Community.

June 28th 1879.

A.R. Price
H.J. Hale.

Road Location & granted July 10th 1879
Plat filed July 7th 1879. Recorded July 8th 1879