


Plat of notes on Road from South terminus of Main Street in Town of Pilot Rock to in-
 Rd # 27-A tersect old Road from Umaticia via M^{rs} Feuney + Eli Siccians to Top of Blue Mountains.
 Copy from Record.

Time employed, one day.
 Parties employed, Viewers S. Craun, J. H. Sharon + R. Sargent
 Craun, Craun, + Sharon
 J. H. Raley Co Surveyor

Set Post Mar R. at South terminus of Main Street in Pilot
 Rock for Comm of Road. thence

Station	Bear	Dist	Remarks
1	South	3-50	"A" Post
2	S 78° E	26-50	"A" ..
3	South	50-00	Set M Post 1
4	"	45.00	"R" " at

intersection of
 old Road from Umaticia to Top of Blue mts
 for terminus of Road

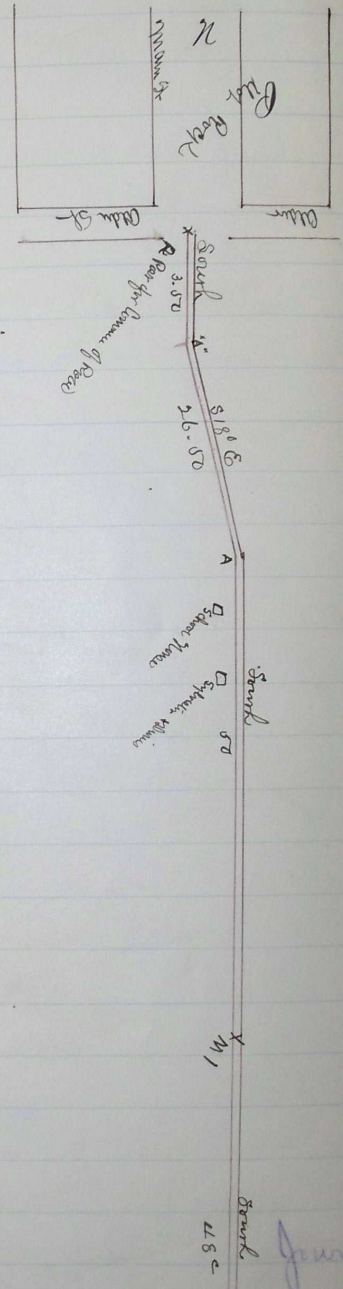

Viewers Report

To the Honorable the County Court of Umaticia County, Oregon.
 We the undersigned viewers appointed at the April Term of
 said Court to view out a County road from the South terminus of
 Main Street in Pilot Rock in said County + State, thence run-
 ning in a southerly direction to or near the school house in
 Dist No 1, thence South on section line by Sycamore + Alder trees to
 intersect a road running from Umaticia Landing via M^{rs} Feuney
 + E. Siccians up the East foot of Birch Creek to the top of the Blue
 Mts, beg leave to report as follows, that we met, on the 15th of
 being duly sworn proceeded to view out, survey + mark off said road
 as required, the views we command the location of the same as a
 County road + believing it to be for the public benefit, it being a
 good + practicable route

J. H. Sharon
 S. Craun
 R. Sargent

Road located by grants July 11 1879
 Filed July 9 1879, Record July 21 1879

Journal 253

