
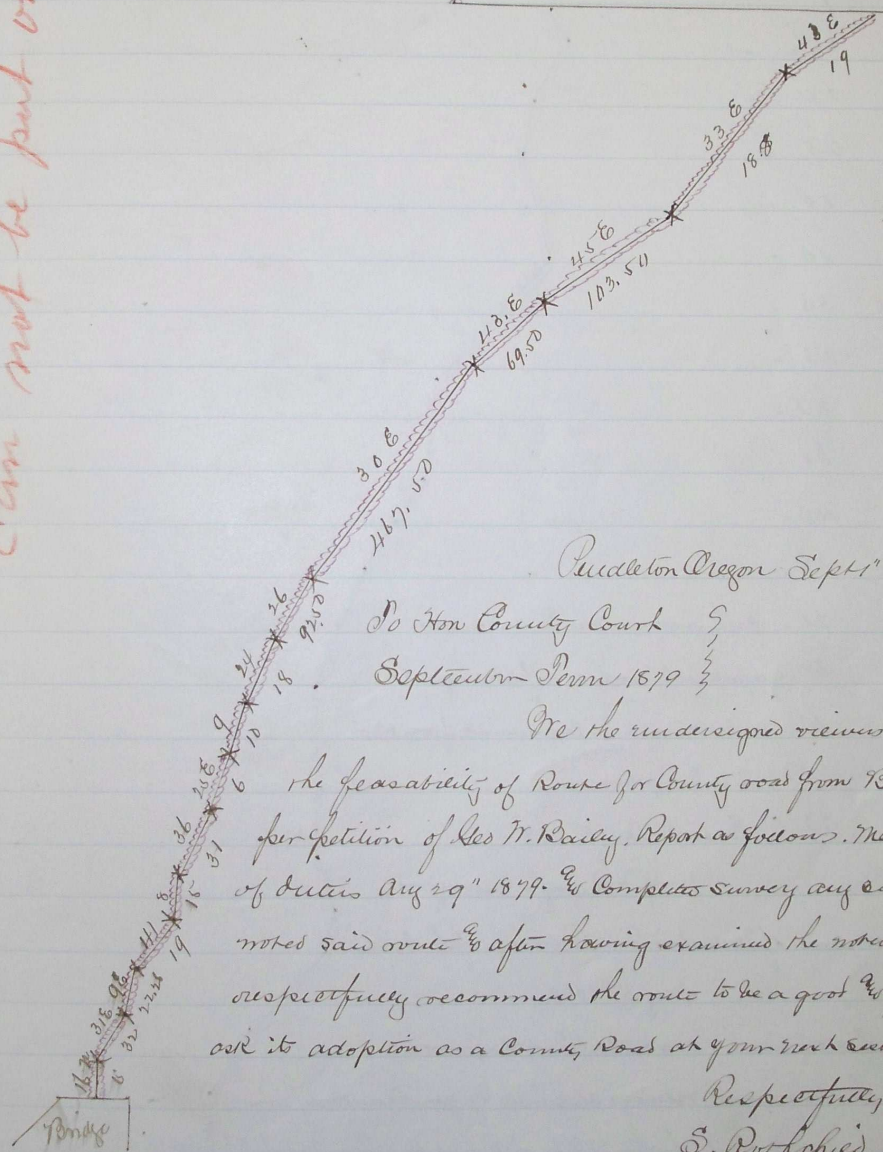


Can not be put on map

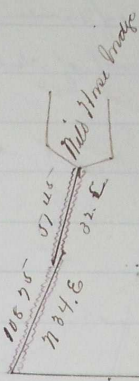


To Hon County Court }  
September Term 1879 }

We the undersigned viewers appointed to investigate the feasibility of Route for County road from Bridge to Culleton as per petition of Geo W. Bailey. Report as follows. Met & entered on discharge of duties Aug 29 1879. & Completed survey Aug 28 Having carefully noted said route & after having examined the notes made by Surveyor we respectfully recommend the route to be a good & practicable one and its adoption as a County Road at your next session

Respectfully  
S. R. K. Hood } Viewers  
W. W. Seagle }

Locate & granted Sept 6 1879, }  
Filed Sept 5 1879. Reported Sept 10, 1879 }

Journal 136