Plat of Road from Milton to Coes Spring

Rd #542

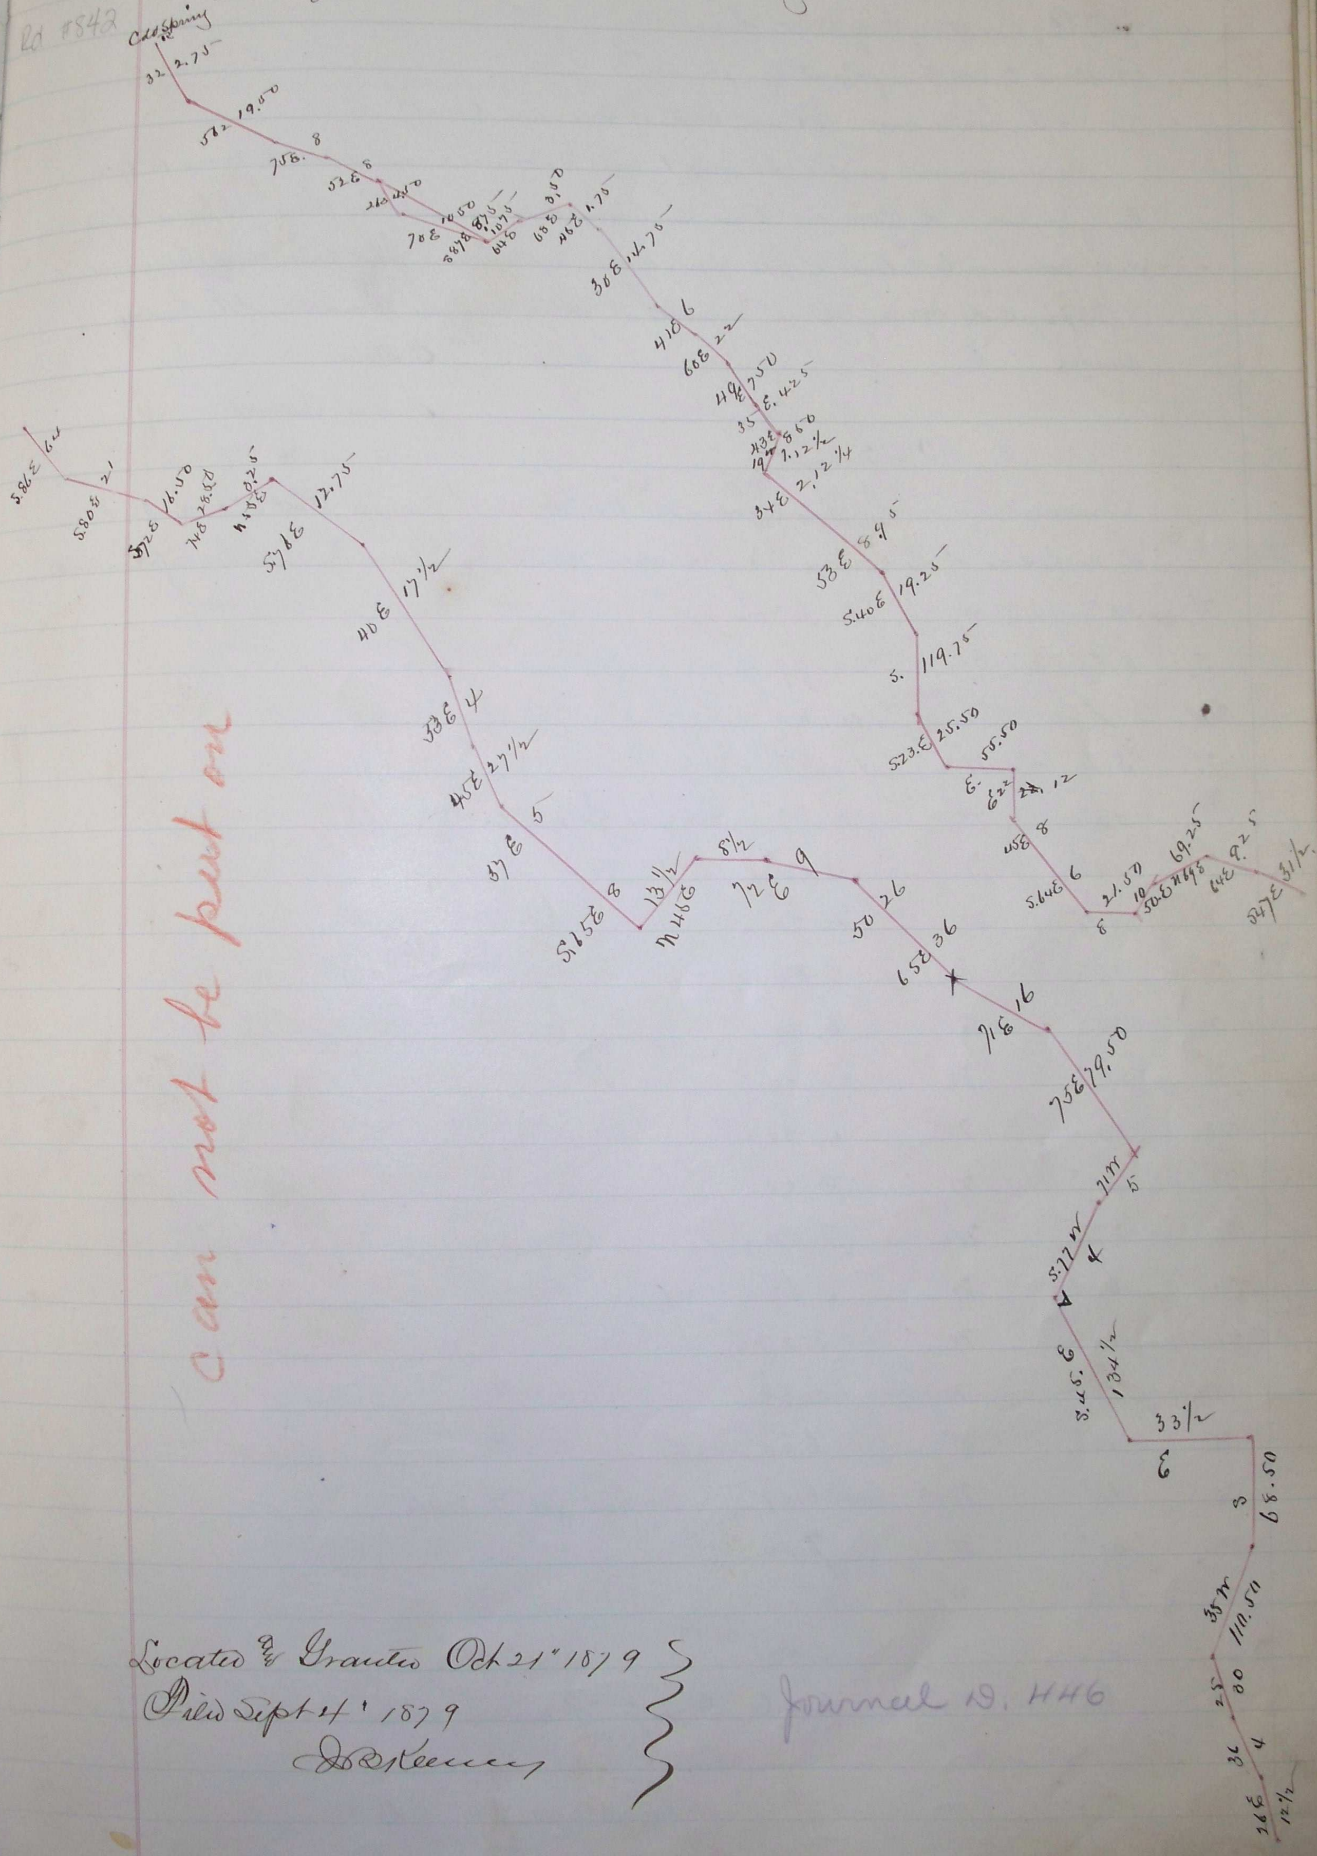

Located & Granted Oct 21st 1879
Filed Sept 1st 1879
D B Keeney