



Rd #93

R. for Terminus, Total length of Road is three miles. Total length of old Road is three miles. I hereby certify that the above is correct as by me taken June 2nd 1880

J. H. Raley

Surveyor

Plat of Road as changed running from Gov 1/4 Post on S. line of Sec 10 T. 3. N. R. 33 to Gov 1/4 Post on West line of Sec 34 T. 4. N. R. 33. T. 3+4. N. R. 33 East

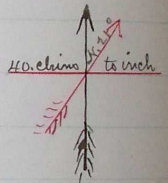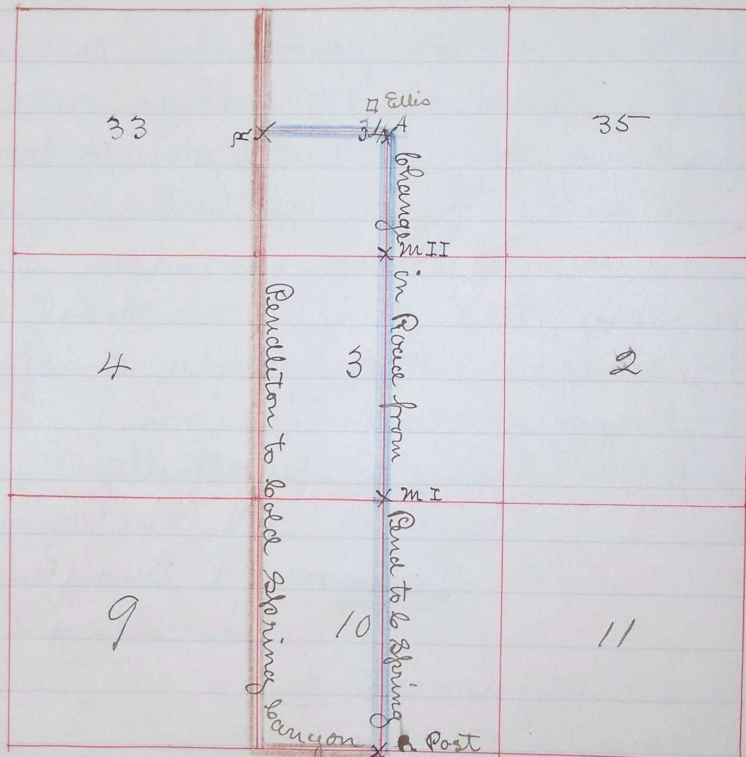

Road located and granted at July term 1880 Recorded July 24th 1880

J. H. Keeneey

County Clerk

Journal 648, D.