


20 190

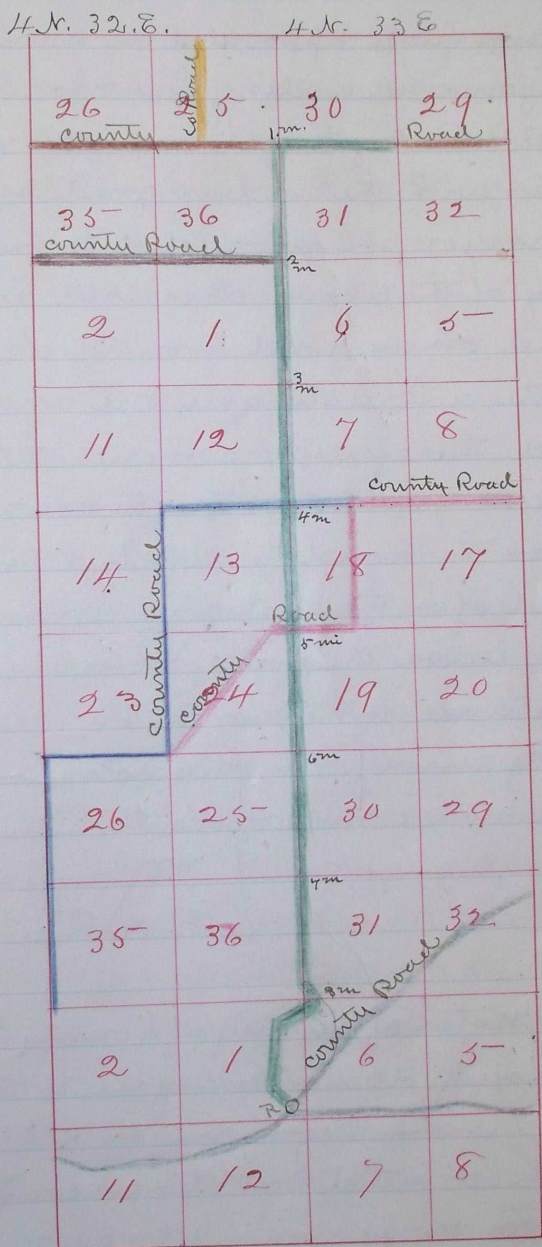

Journal 0608
 " 8 114