


Tp. 5 N. R. 36 East.

Rd #89

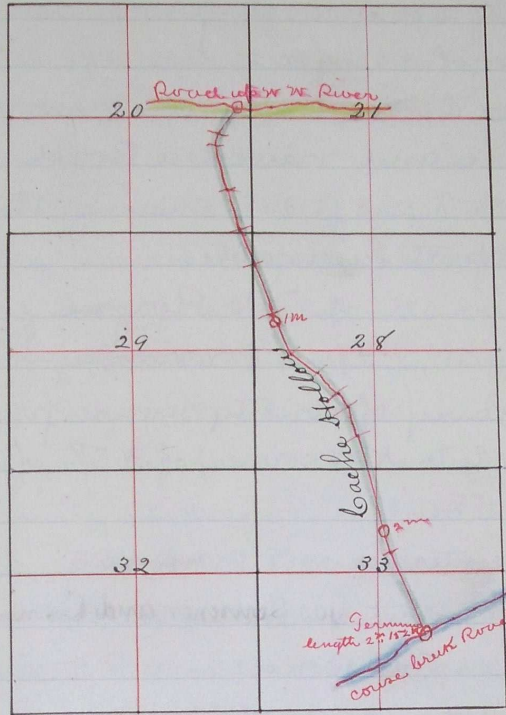

Plat of Bounty Road from Geo. Dehavens to Geo. Suttons

Scale 160 ch to 1 inch

Recorded Sept 21 1880

J. Arnold Surveyor

J. Keeney clerk

Journal 10 551

" " 600

6 115