


221 #58

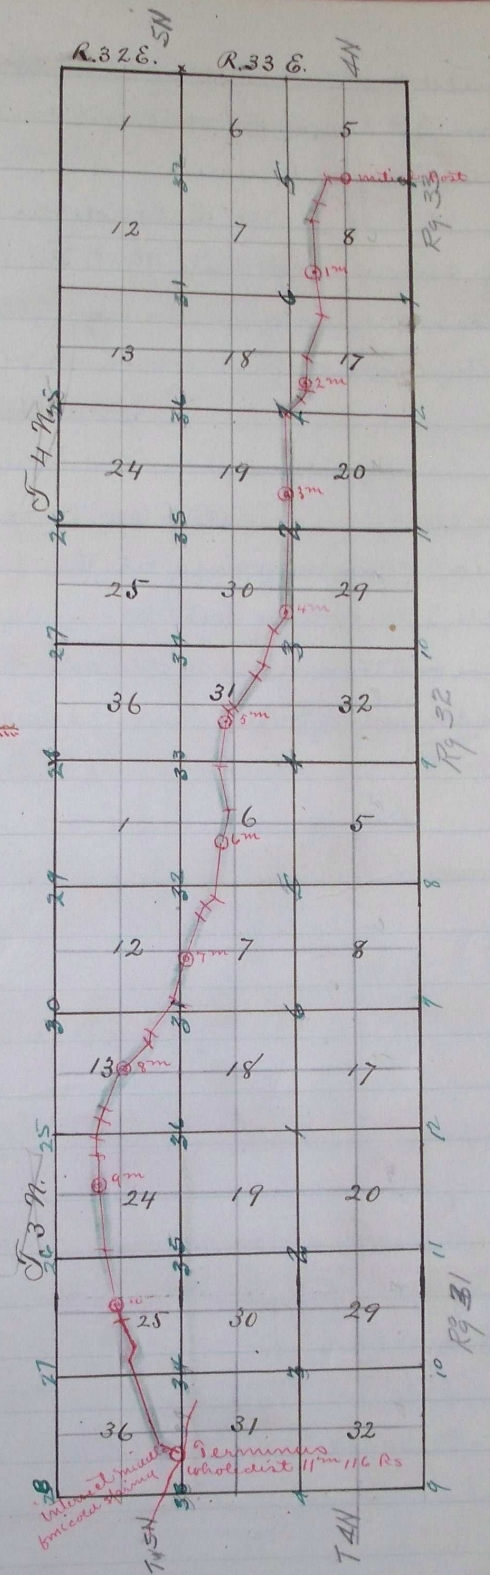

Plat of bounty Road from 1/4 sec cor bet secs 5 & 8
 T.4 N R 33 E down r fork to intersect middle fork cold spring
 Canon Matilla county Oregon scale 80' to 1" in
 J. B. Arnold
 Surveyor

Journal 10529
 " " 603
 " " 846