


Ed # 86

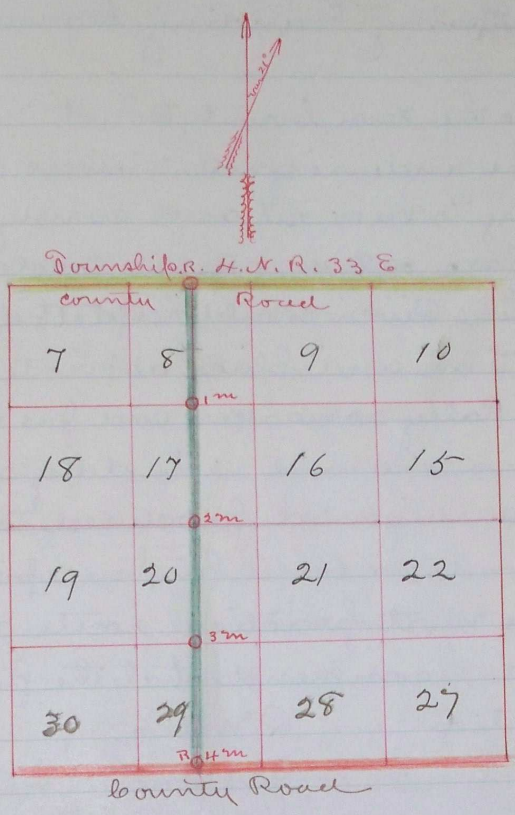

Plat of Road from 1/2 mile post on north line
 of Sec 8 to 1/2 mile post on south line of Sec 29
 of Township 7. Range designated
 Scale 80 chains to 1 inch

J. H. Raley
 Surveyor

Recorded Sept 22nd 1880

J. H. Raley Clerk

By M. F. White Deputy

Journal 10 5-78

" 2. 602

" 3. 41