


6182

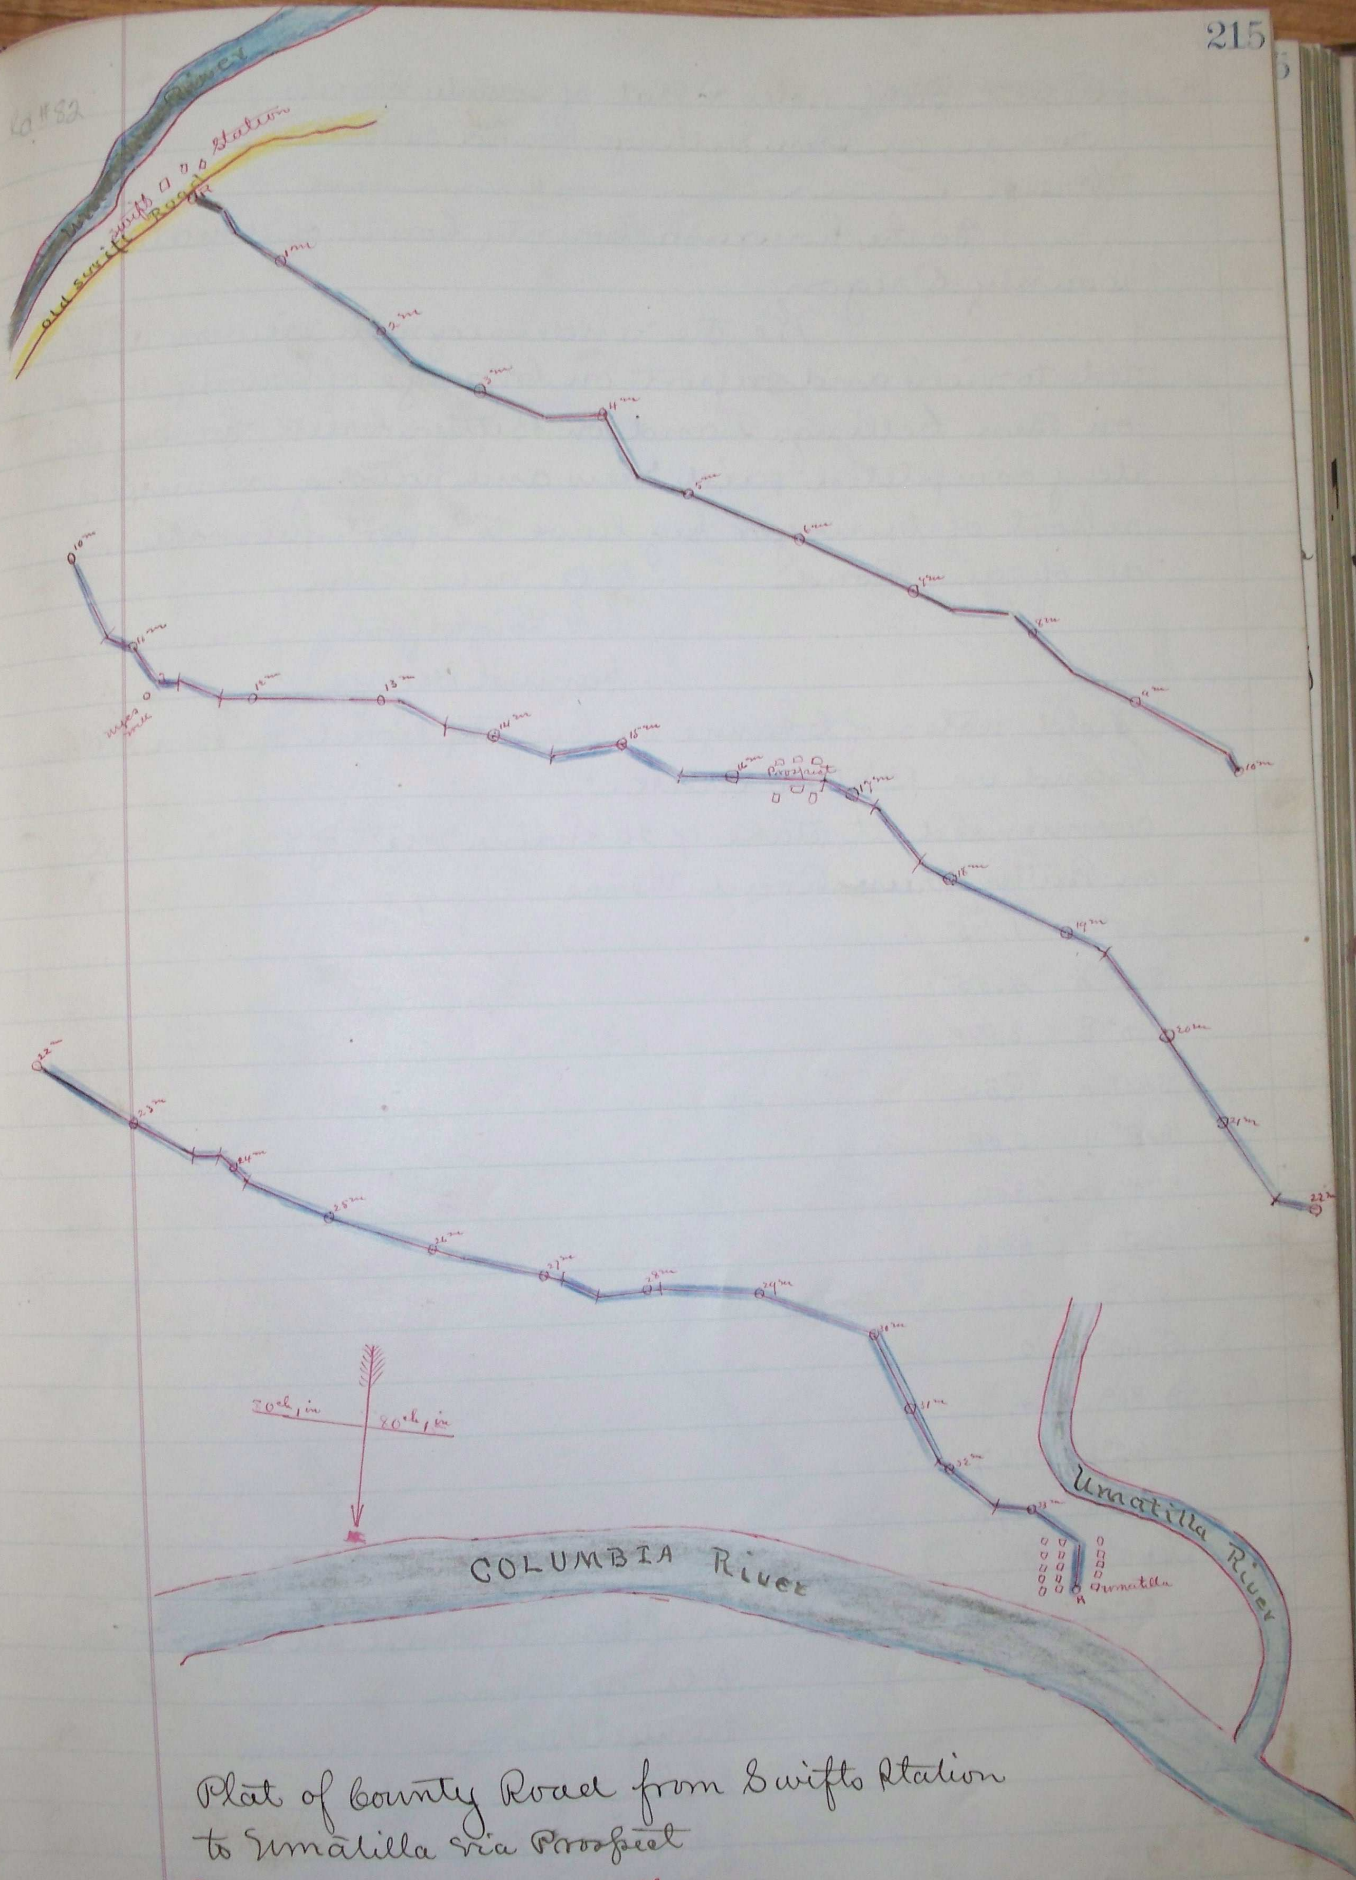

Plot of County Road from Swifts Station
 to Umatilla via Prospect
 Journal D. Page 607
 " E. " 43