

Rd #81

4mL

"

"

"

"

"

"

"

"

"

"

"

"

"

"


"

"

"

"

Middle Fork Gold Spring

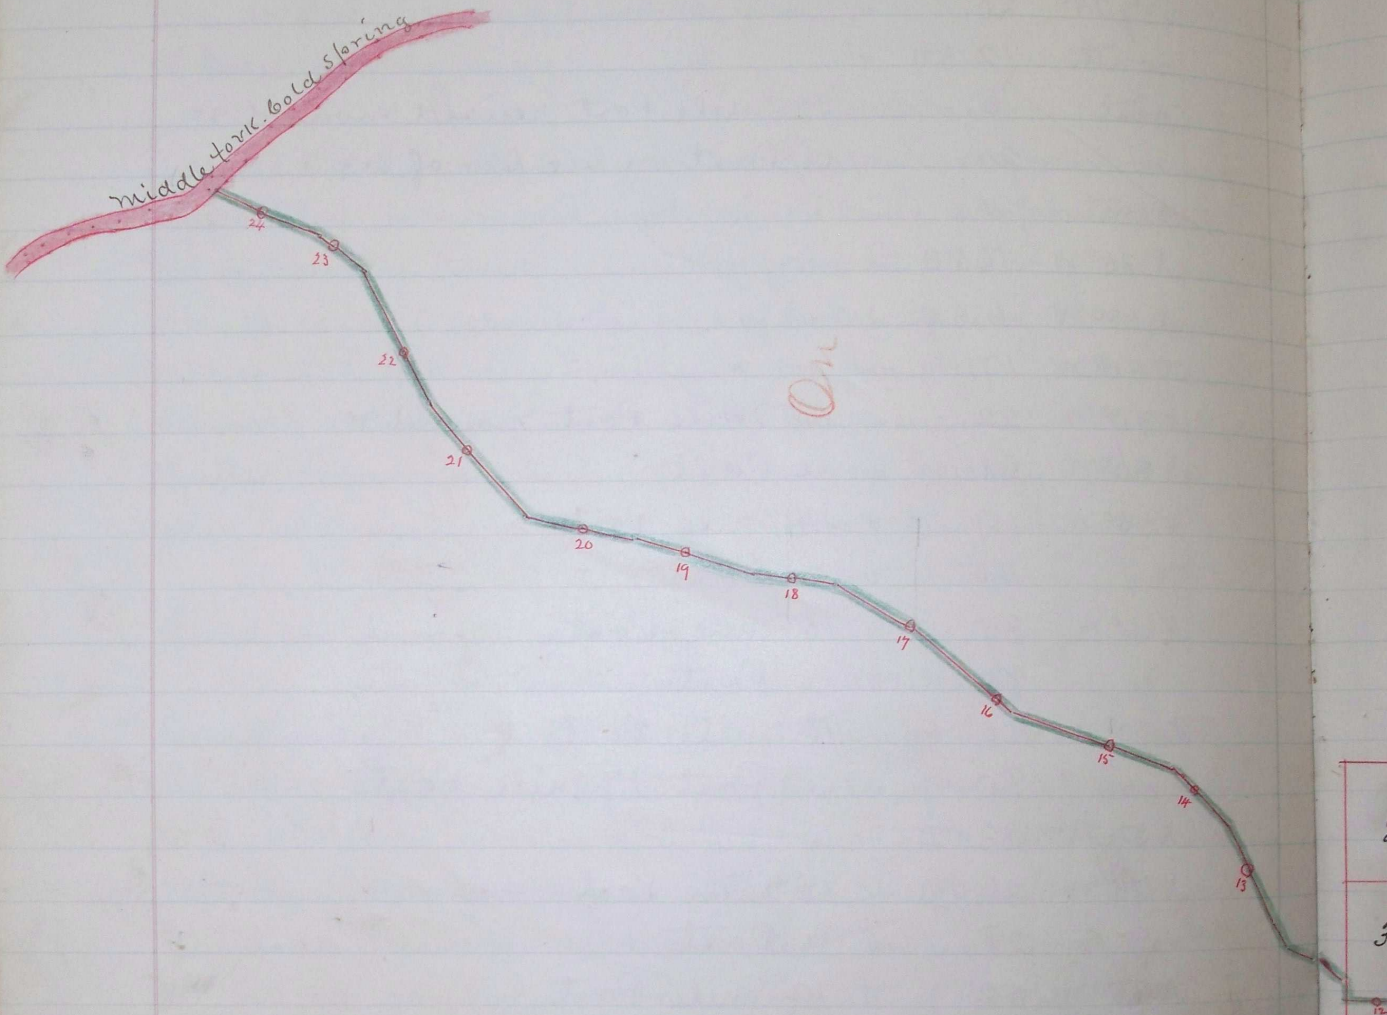

Rd #81

2
3
4