

Report. Field Notes. & Plat of County
 Road from. N E cor of sec 24 T. 4 N R
 34 E. & running South on the township
 line to the S. E. corner of sec 36 T. 4 N R 33 E

To the honorable county court of Umatilla County Oregon
 We the undersigned who were appointed at the last
 term by your honorable body to review a road beginning
 at the North East corner of section 24 T. 4 N. R. 34
 East and thence running South to the South East corner
 of section 36 T. 4 N. R. 33 East would respectfully
 Report that we have this day viewed the Road as described
 and would report favorably upon the above Road
 that there are no natural obstacles whatever upon the
 line of the Road to deter travel and that in our judgement
 the above described Road would greatly benefit the
 people living in that vicinity

Henry Krebs
 Robert E Eastland

Field Notes

County Road commencing at the N E cor of sec (24) T. 4
 N of R. 33 E of T. 4. thence on the Town line between Range 33
 & 34 E of T. 4


commencing at the S E corner of sec 36 in T. 4 N R 33 E
 of T. 4. on town line set post mark 1 lb. and built mound
 and intersect Road running E & W

on said line set post marked 11 m built mound

on said line set post marked 111 lb. and built mound
 at intersection of Road course East

B. B. Trade chairman A. B. Saffrey 1st Surveyor
 James Means
 C. B. Trade marker

Initial point
 Journal D 562. + 604
 " E 37 + 70

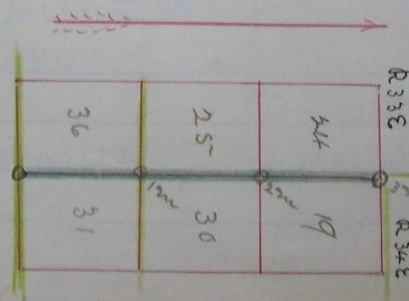

49
 intersect Road leading to
 centerline
 surveyed Road
 Cross Roads