


LA 145

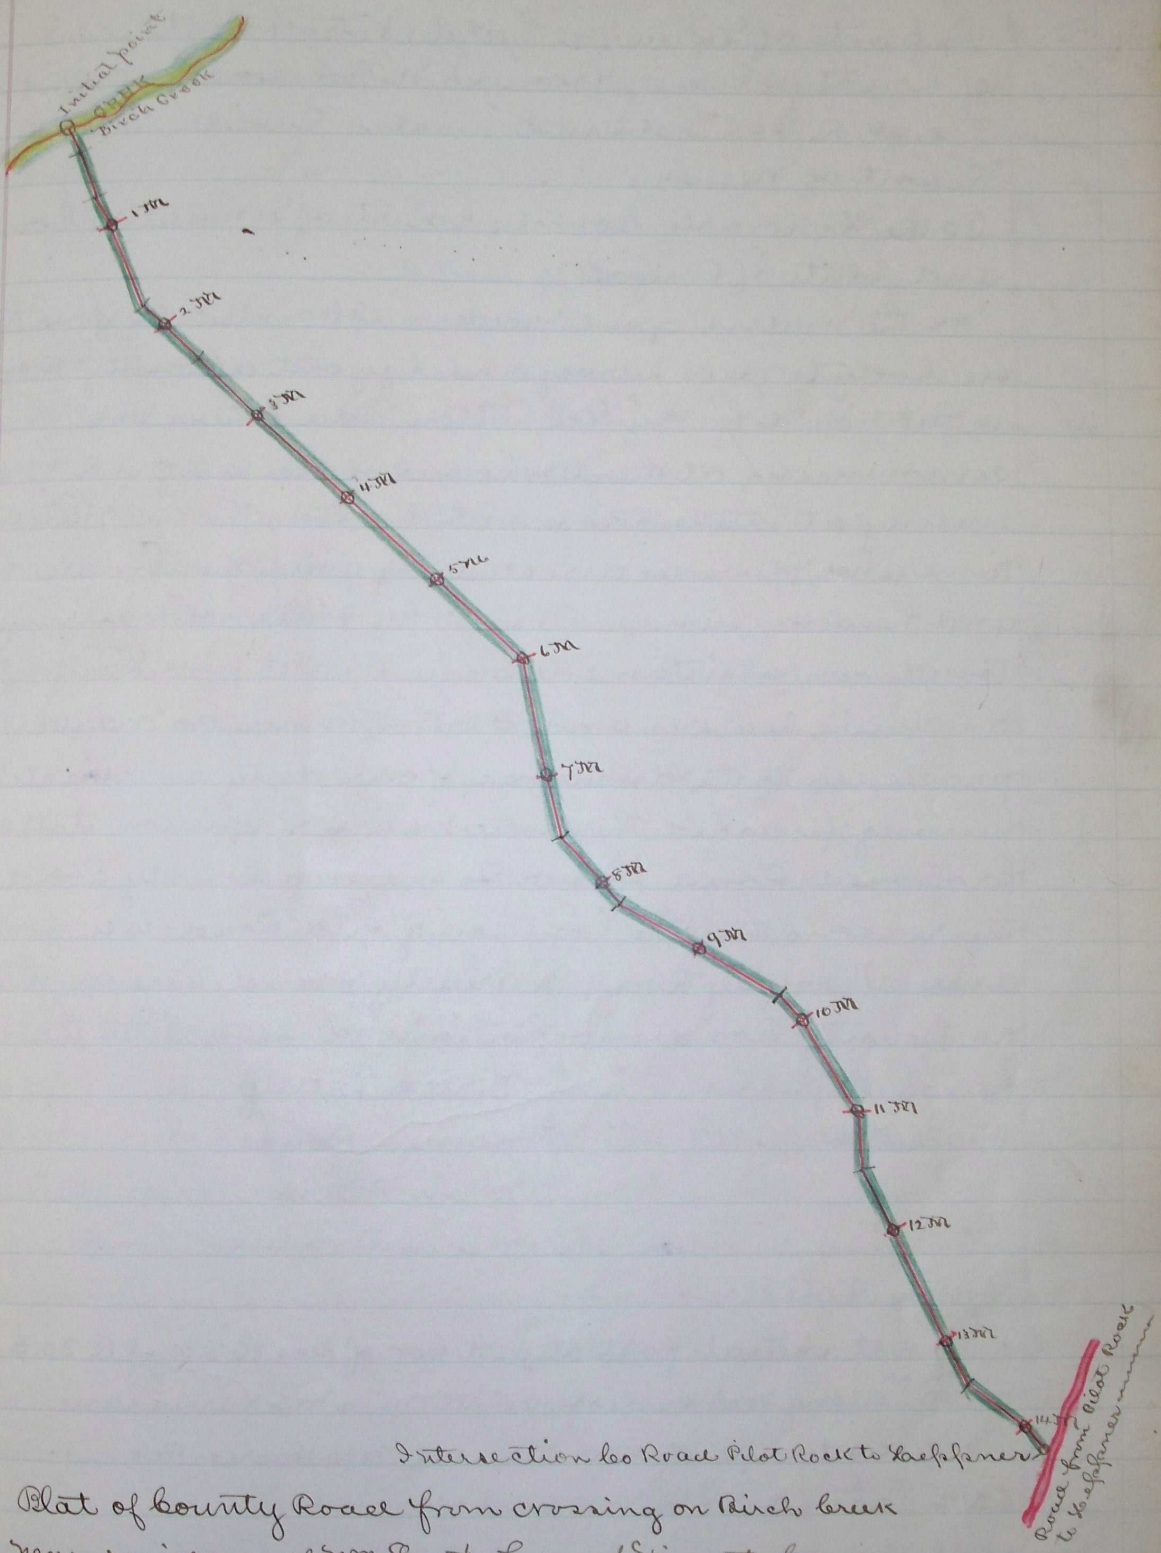

Plot of County Road from crossing on Birch Creek
near residence of Mr. Lees to head of Vincents Canyon
Journal 10. 578

- " " 602
- " E. 38
- " " 71