


Butter Creek

Plot of County Road from old Emigrant crossing on Butter Creek via Brassfields Ferry to intersect Penelton + Unmatilla Co Road

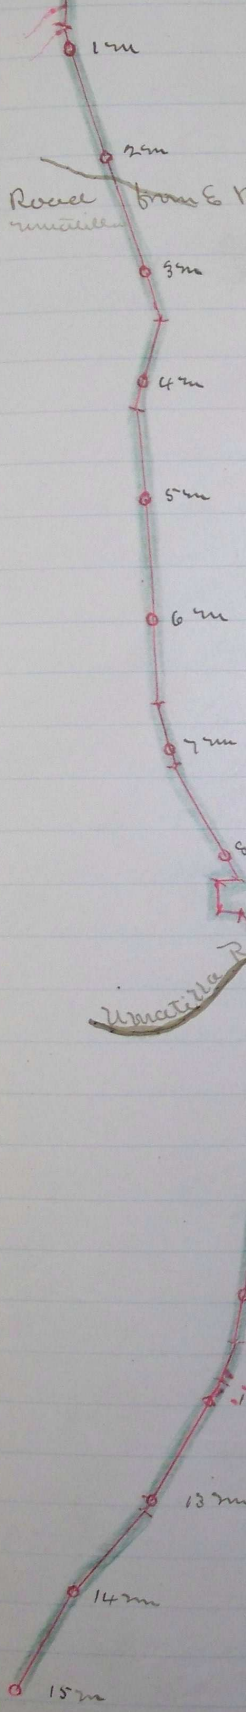


Road from E Butter creek to unmatilla

Unmatilla Road

U S M R

Can not be put on

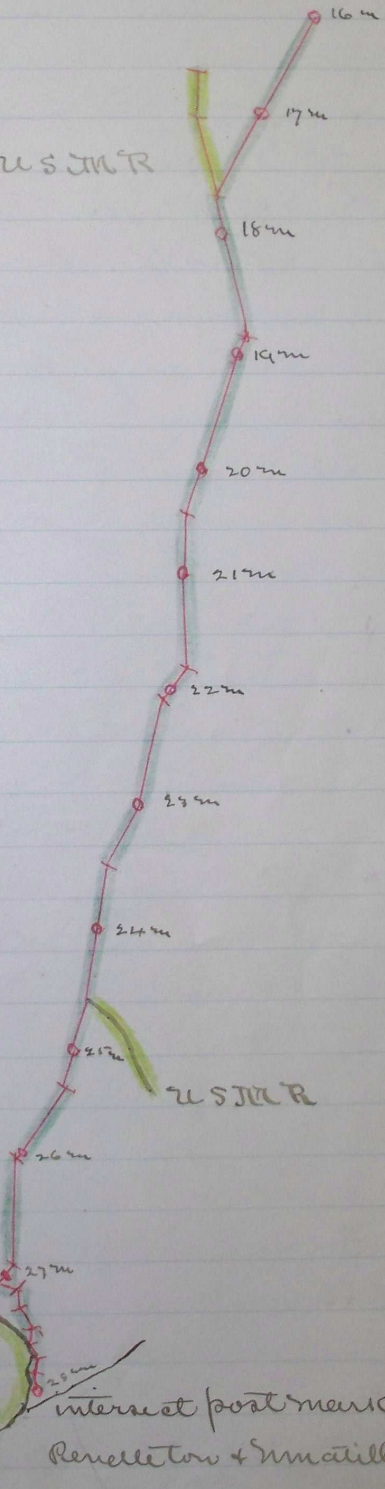

interact post market on Penelton + Unmatilla R

U S M R