

Map of Road from Clarke's Canyon by the way of O'Farrar's Field and Gilliam's Ranch to the South line of Umatilla County.

1/2 mi

"

































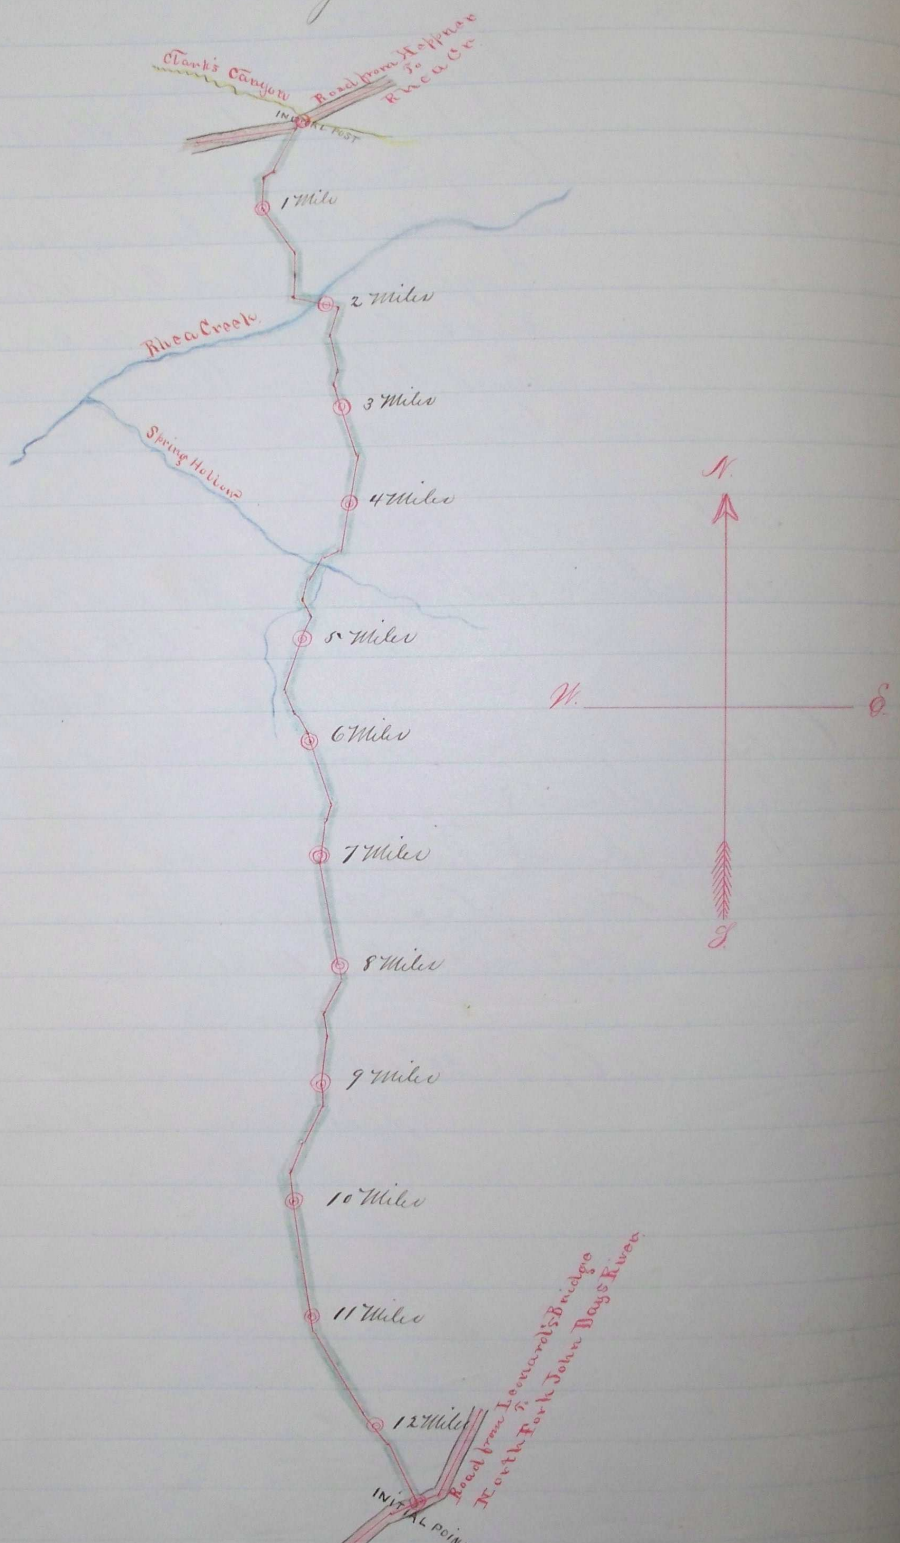

Stud April 4th 1881.
 & Recorded April 30th 1881.
 J.B. Keeney Clerk.
 Journal '81 159 Page