


	Ch	ks	
J 20	80	00	Old fork worked 3 Miles
" "	80	00	" " " " "
" "	35	00	Angle chosen
" 13° 44"	57	50	Angle chosen
" 10° 8"	71	50	Angle chosen
Route "	80	00	Old fork worked 5 Miles and intersects road leading from Pendleton to Umatilla & Chain's Work of the Bridge.

(Filed April 30/1881)

Rd #101

Road from Weston to Pendleton

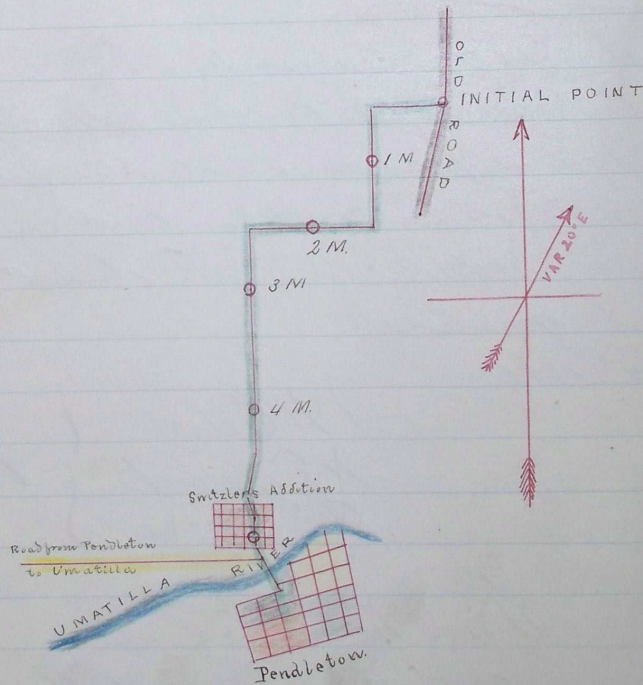

I hereby certify that the within is a true and correct return of the Plat of the within named Road.
 21 day of April 1881.

John Raby County Surveyor
 By A. W. Coffey Deput