


Co #115

Road running up and across Mild Horse Creek intersecting road from
Centerville to Pennington

3N

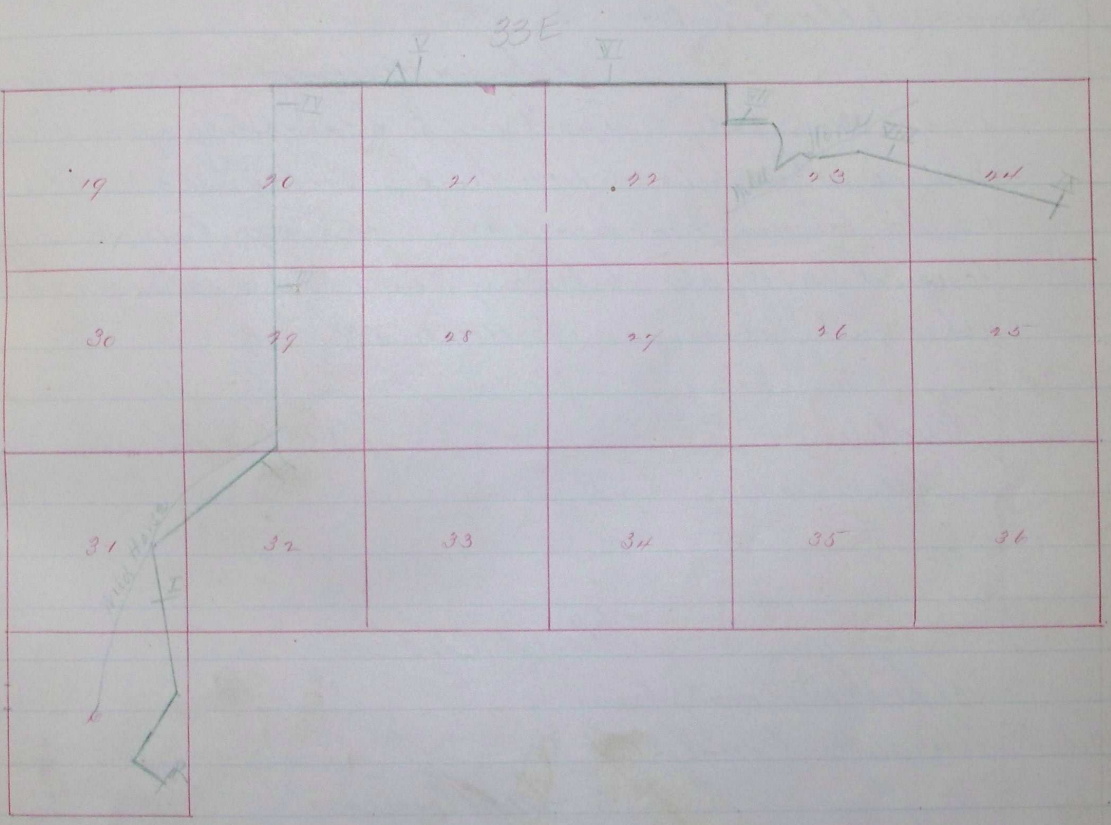

Journal E page 368
" E " 209 Pennington