160

278
280

Rd #116

PLAT
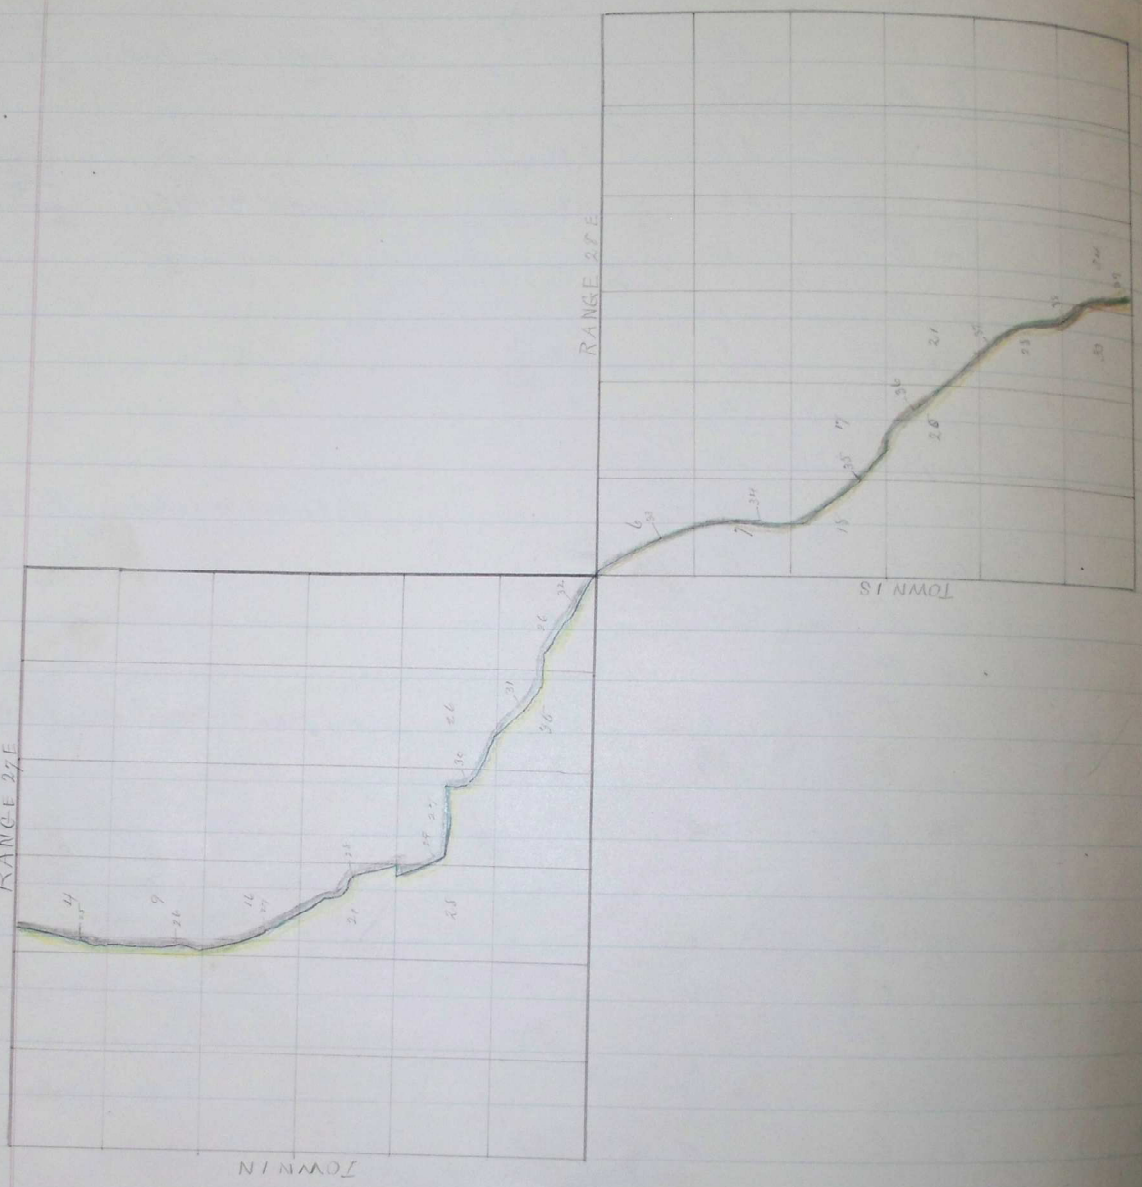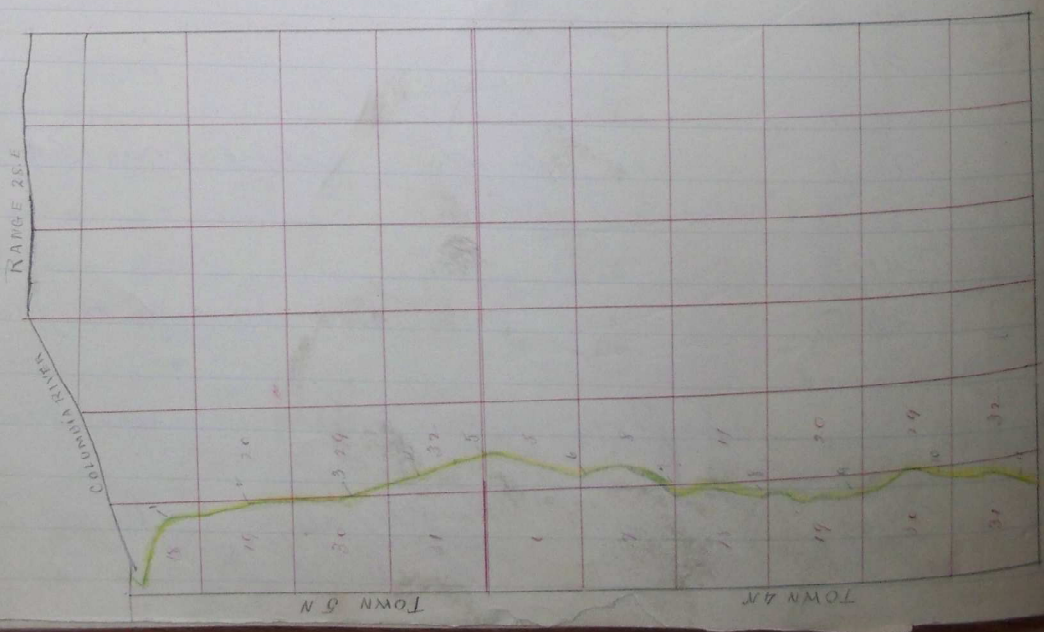
County Road from Umatilla City to Cottonwood on Little Butter Creek