


\$ 378	66.00	Angle chimes
0108	80.00	Set Post marked 3 m
" "	80.00	Set Post marked 4 m and Angle chimes
0218	20.00	Angle chimes
0598	37.00	Angle chimes
\$ 298	80.00	Set Post marked 5 m chimes
\$ 358	75.00	Intersect the Road leading to Collins mill and set post marked R this being an divide between Little + Big Beaver Creek

132
 Mr. Commissioner
 of the State of Oregon
 Salem

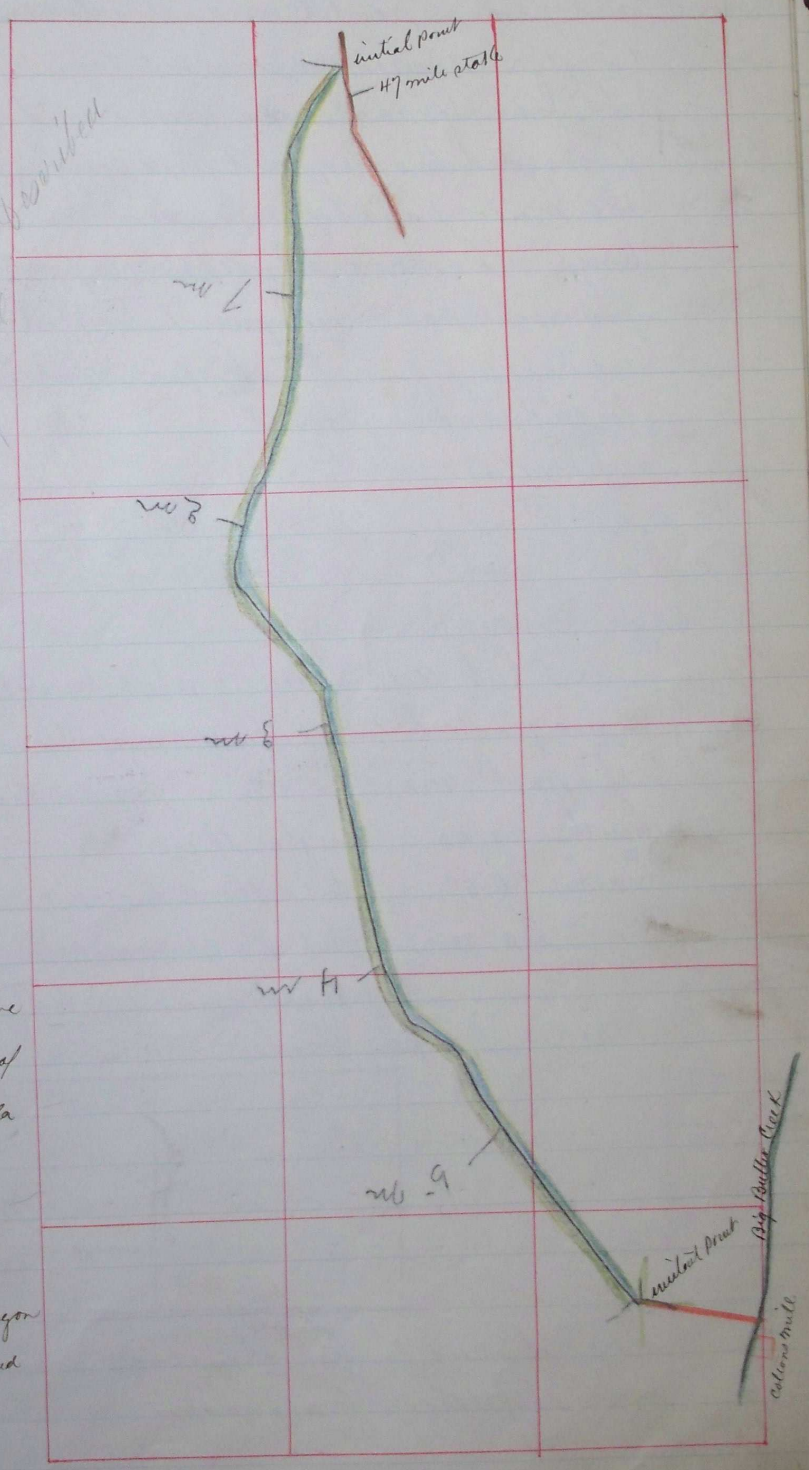

four & page 517
 four & page 503

I hereby certify that this above is a true plot of the change of road running from Umatilla city to Collins mill this Aug th 11th 1882

A L Coffey

County Surveyor, Umatilla, Co Oregon
 Chairman, Wm Douglass and
 James Means
 or Wm D M Rinehart

Scale 2 in to the mile