160

320

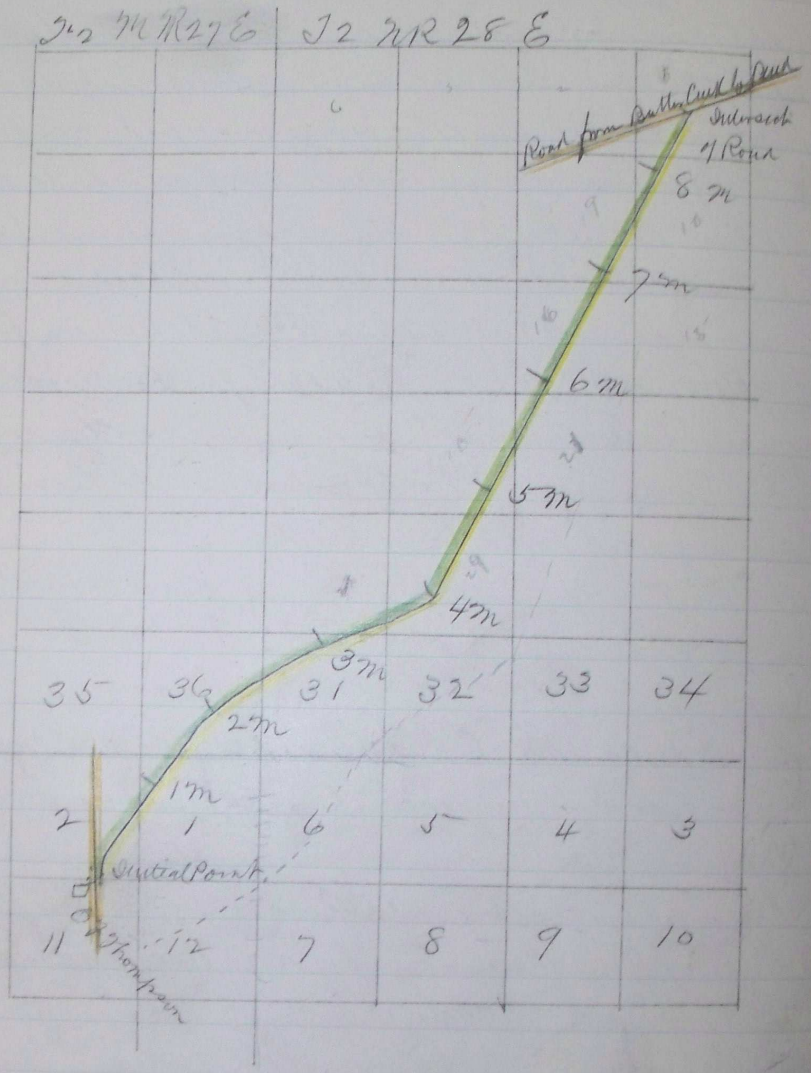

I hereby certify that the above plat and field notes of the above named road is true and correct.

This 27th day of September 1887

A L Coffey

County Surveyor Umatilla Co Oregon

Chainmen

Symus Van Auken

John McCarty

Marker

S L Morse

Journ E page 519

Journ E page 639