Field Notes & Plat of Survey of a County Road from State Line to town of Milton Oregon.

In the matter of the Survey of a County road from the State line to Milton as follows, to-wit: Commencing at a point on the State line between the State of Oregon and Washington Territory.

Commencing S.50 west where the Sec line between 14 & 15. Set post marked R for commencing point.

17.50 Set angle post marked A. Road bears South 20° East
34.00 Set angle post marked A Road bears South
80.00 Set post marked 1 M
29.00 Set Angle post.
31.50 Set Angle post
47.00 Set Angle post
80.00 Set post Marked 2 M. Course South
80.00 Set post marked 3 M " "
9.60 Set Angle post Marked A. Road bears S 45° E.
71.00 Set angle post Marked A Road bears S. 31° E
70.00 Set post marked 4 M. Road bears S. 31° E
70.00 Set post marked 5 M. Road bears S. 31° E.
1.00 Set angle post marked A Road bears S. 29° E
44.00 Set post on Main Street in the town of Milton, marked R

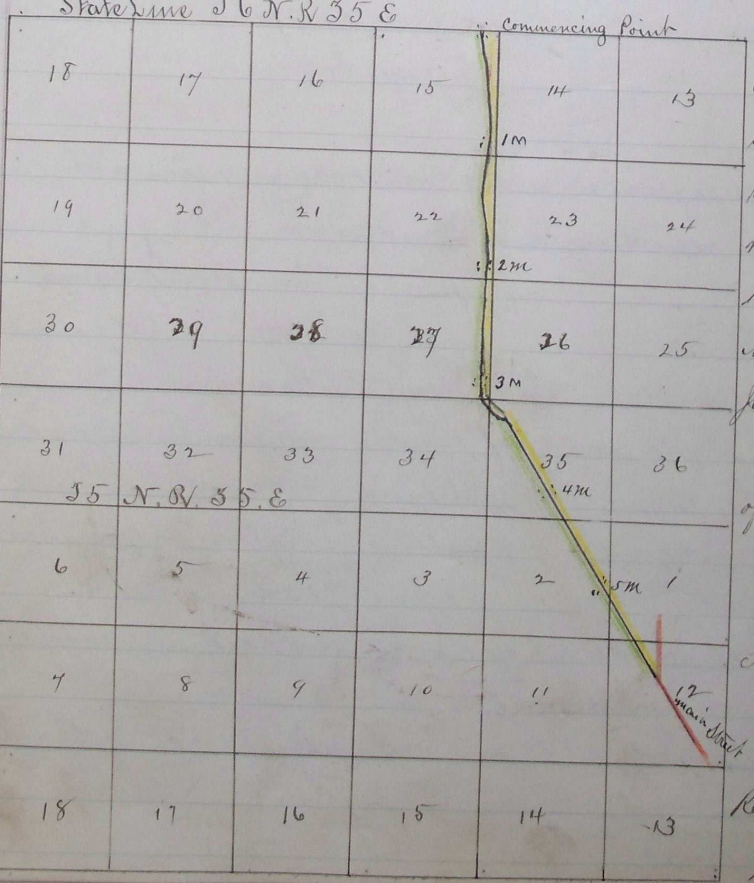

I hereby certify that the above is a true & correct survey & plat of road leading from the State line near the residence of Ransom Wells to Main Street in the town of Milton Umatilla County. Oregon July 31st 1882

A L Coffey Surveyor of Umatilla County Oregon
By T. M. Coffey Deputy

Filed Sept 5. 1882
J R Busher Clerk
By C P Edmunds Deputy

Recorded March 28 1883
J R Busher Clerk