


380

LN 34/E

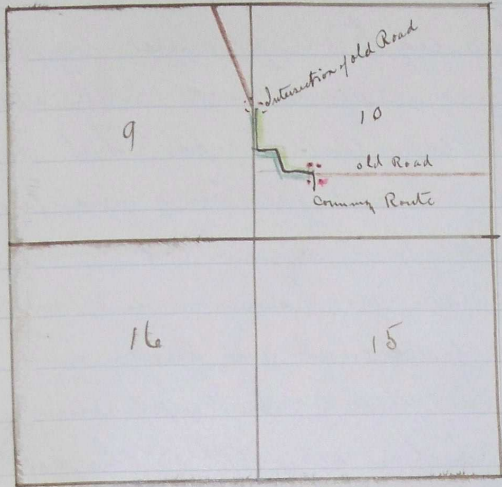

I hereby certify that the within is a true and correct survey of the change in the road leading from Geer Springs to Gerking flat through the land of Reubin & Fallon
 This 21st day of April 1883

John E page 706
 John E page 766

A L Coffey
 County Surveyor
 Umatilla County Oregon

Recorded May 24 1883
 J P Bushee Clerk

ing
 10