350
ROAD No
150

Plat of Survey of County Road leading from Heppner to intersect Sand Hollow Road at the S. W. corner of NW¼ Sec 18. T. 1 S R 27 E. (Road No 150)

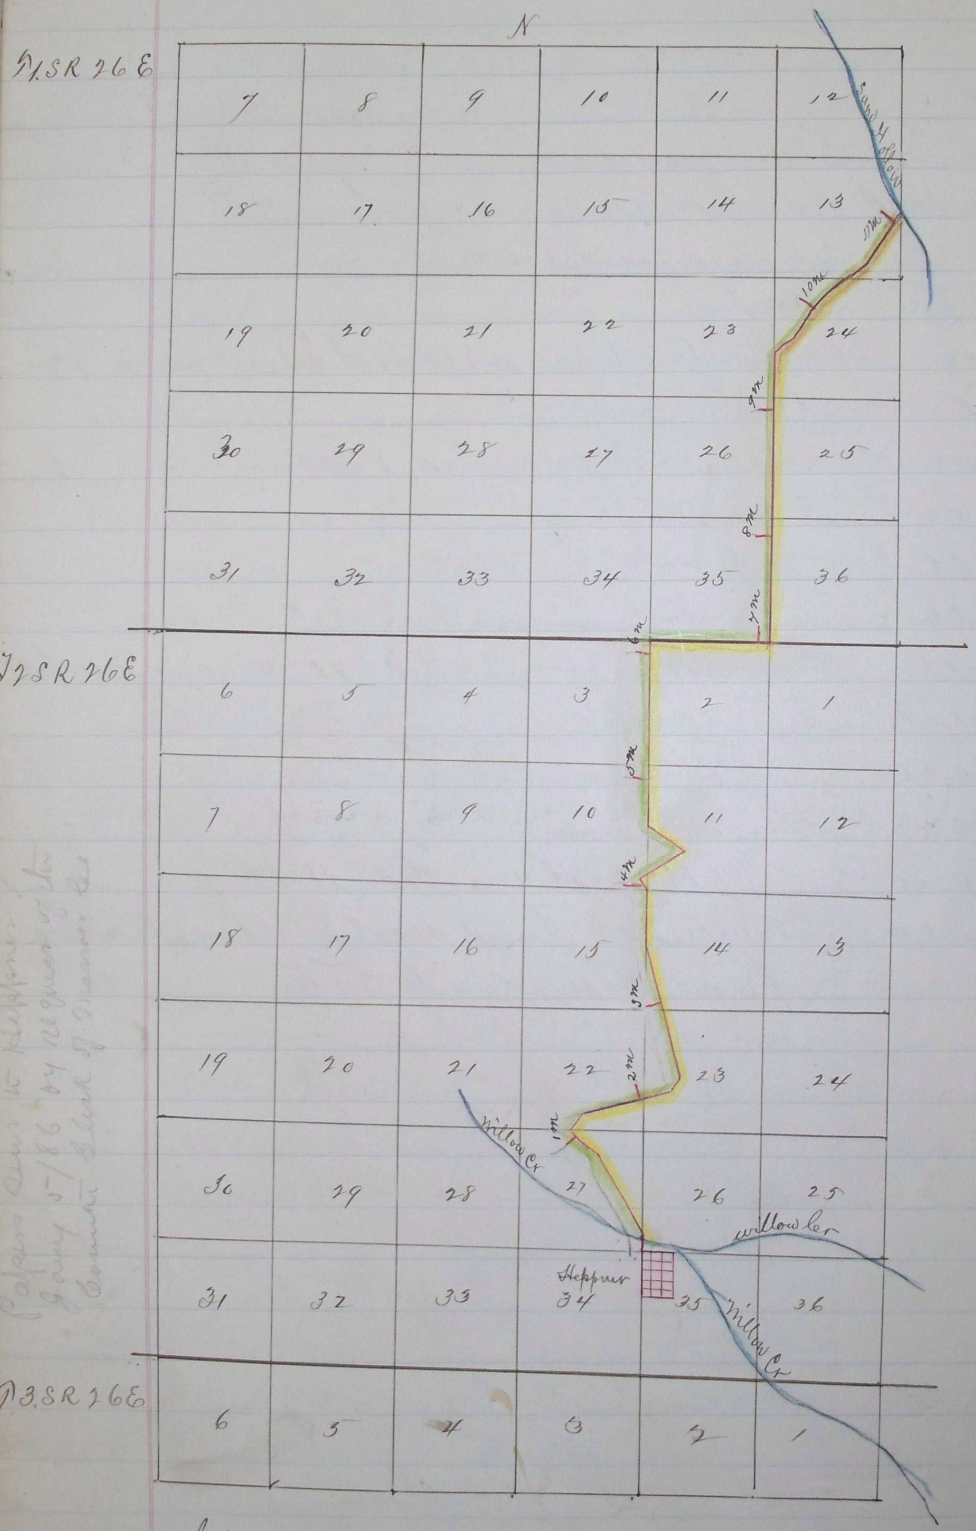

I hereby certify that the above is a true and correct survey and plat of the above road No 150. This 31st day of May 1883

Jour E page 738
" " 50

A L Coffey
County Surveyor Umatilla Co Oregon

Recorded aug 2 1883
J P Brosher Clerk