352

Plat of Survey of County Road from near I H Quinns residence Gerking Flat to residence of E Broughton

Road # 153

T 5 N. R 34 E.

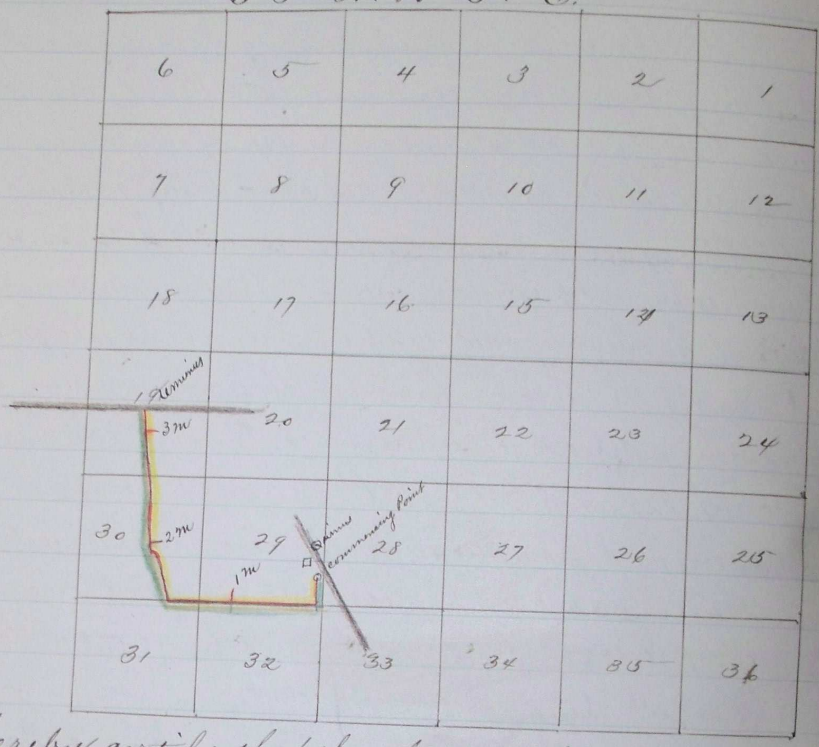

I hereby certify that the above plat is a true and correct plat and survey of Road No. 153. This 18th day of May 1883

A L Coffey
County Surveyor of
Umatilla County Oregon

Jour E page 141
" F " 52.

Recorded August 2d 1883
J P Bushee
Clerk